


SECTION

TOWNSHIP 17S, RANGE 6W, W. M.

North

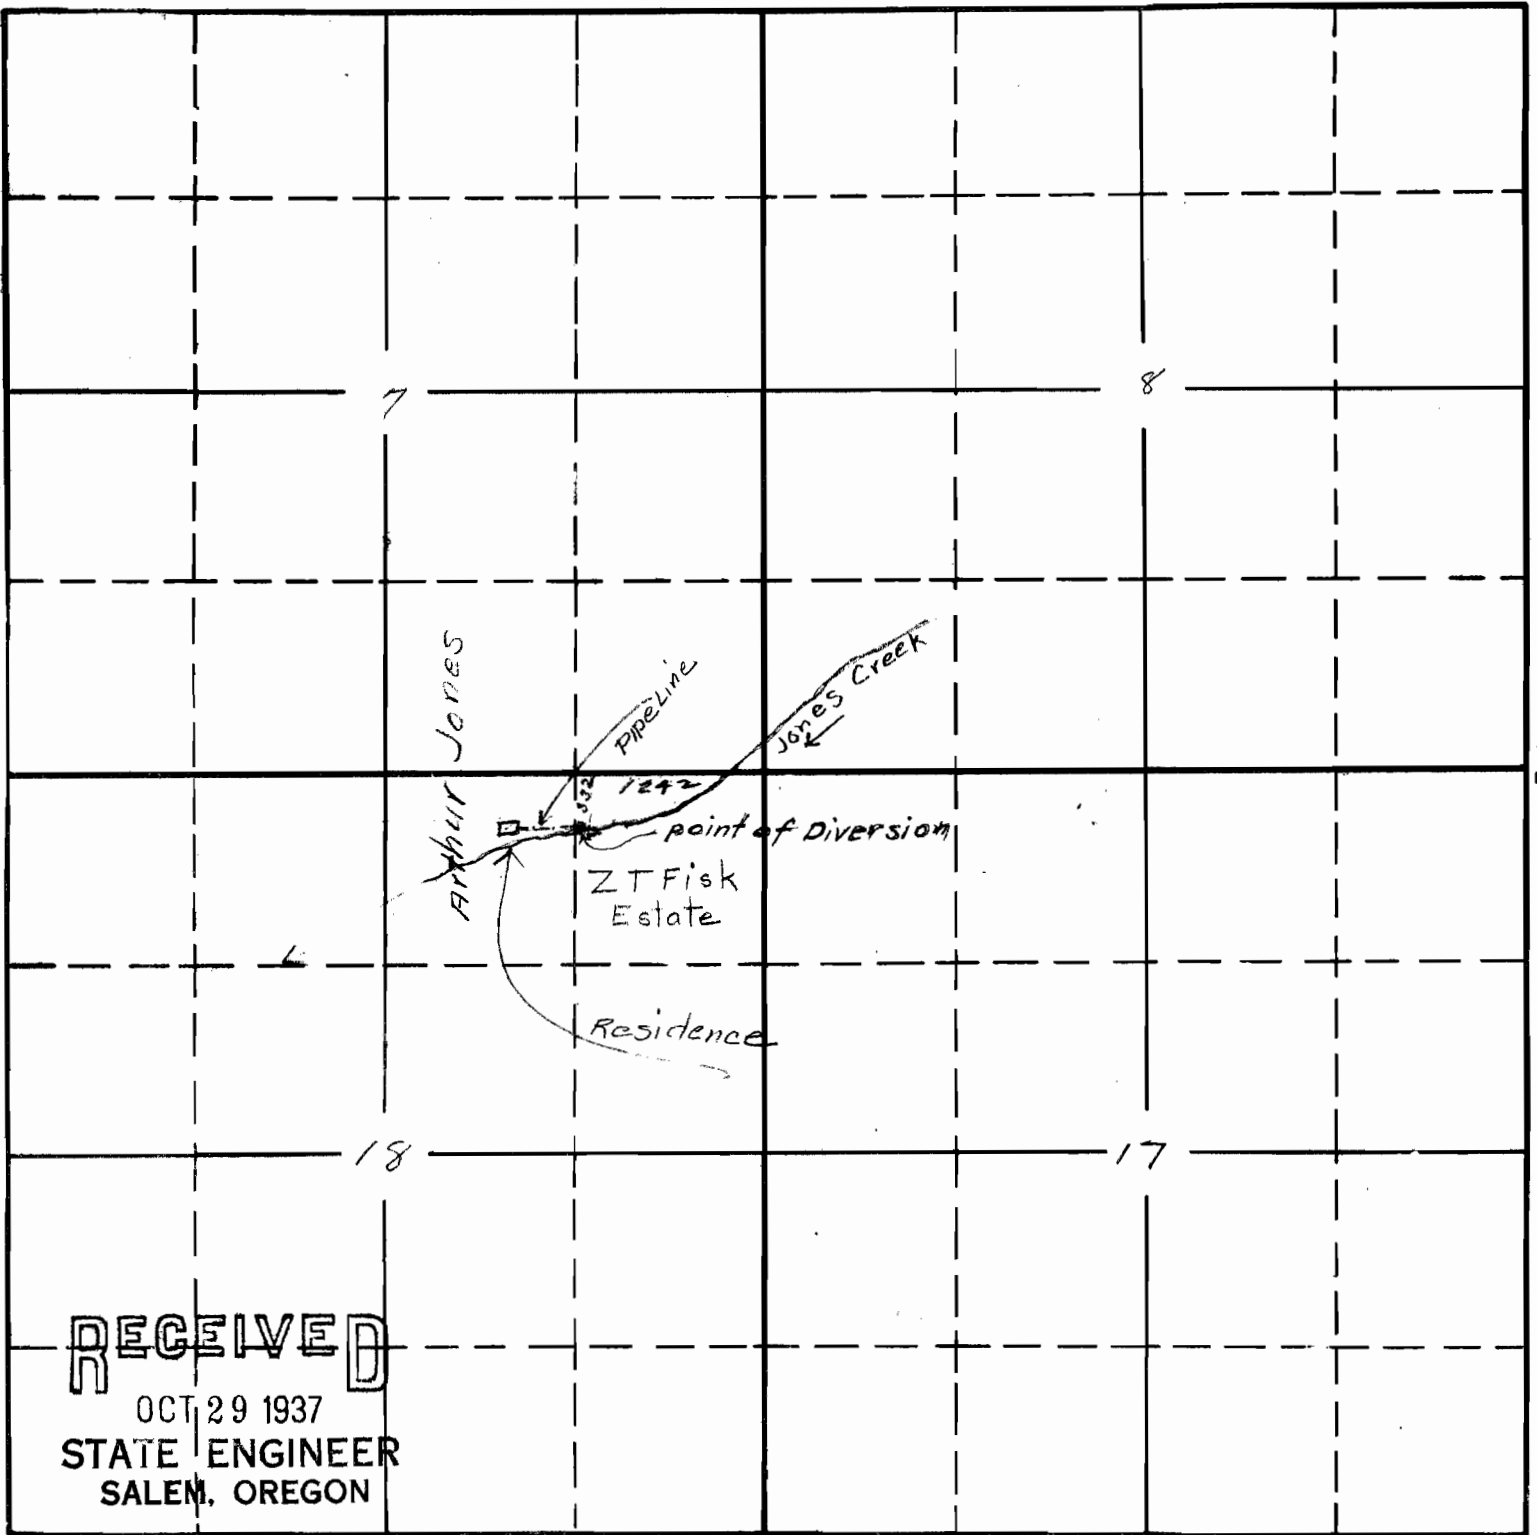

RECEIVED

OCT 29 1937
STATE ENGINEER
SALEM, OREGON

South

RECEIVED

NOV 8 1937

STATE ENGINEER
SALEM, OREGON

APPLICATION No. 17145
PERMIT No. 12866