


C-12227

U-93
U-93

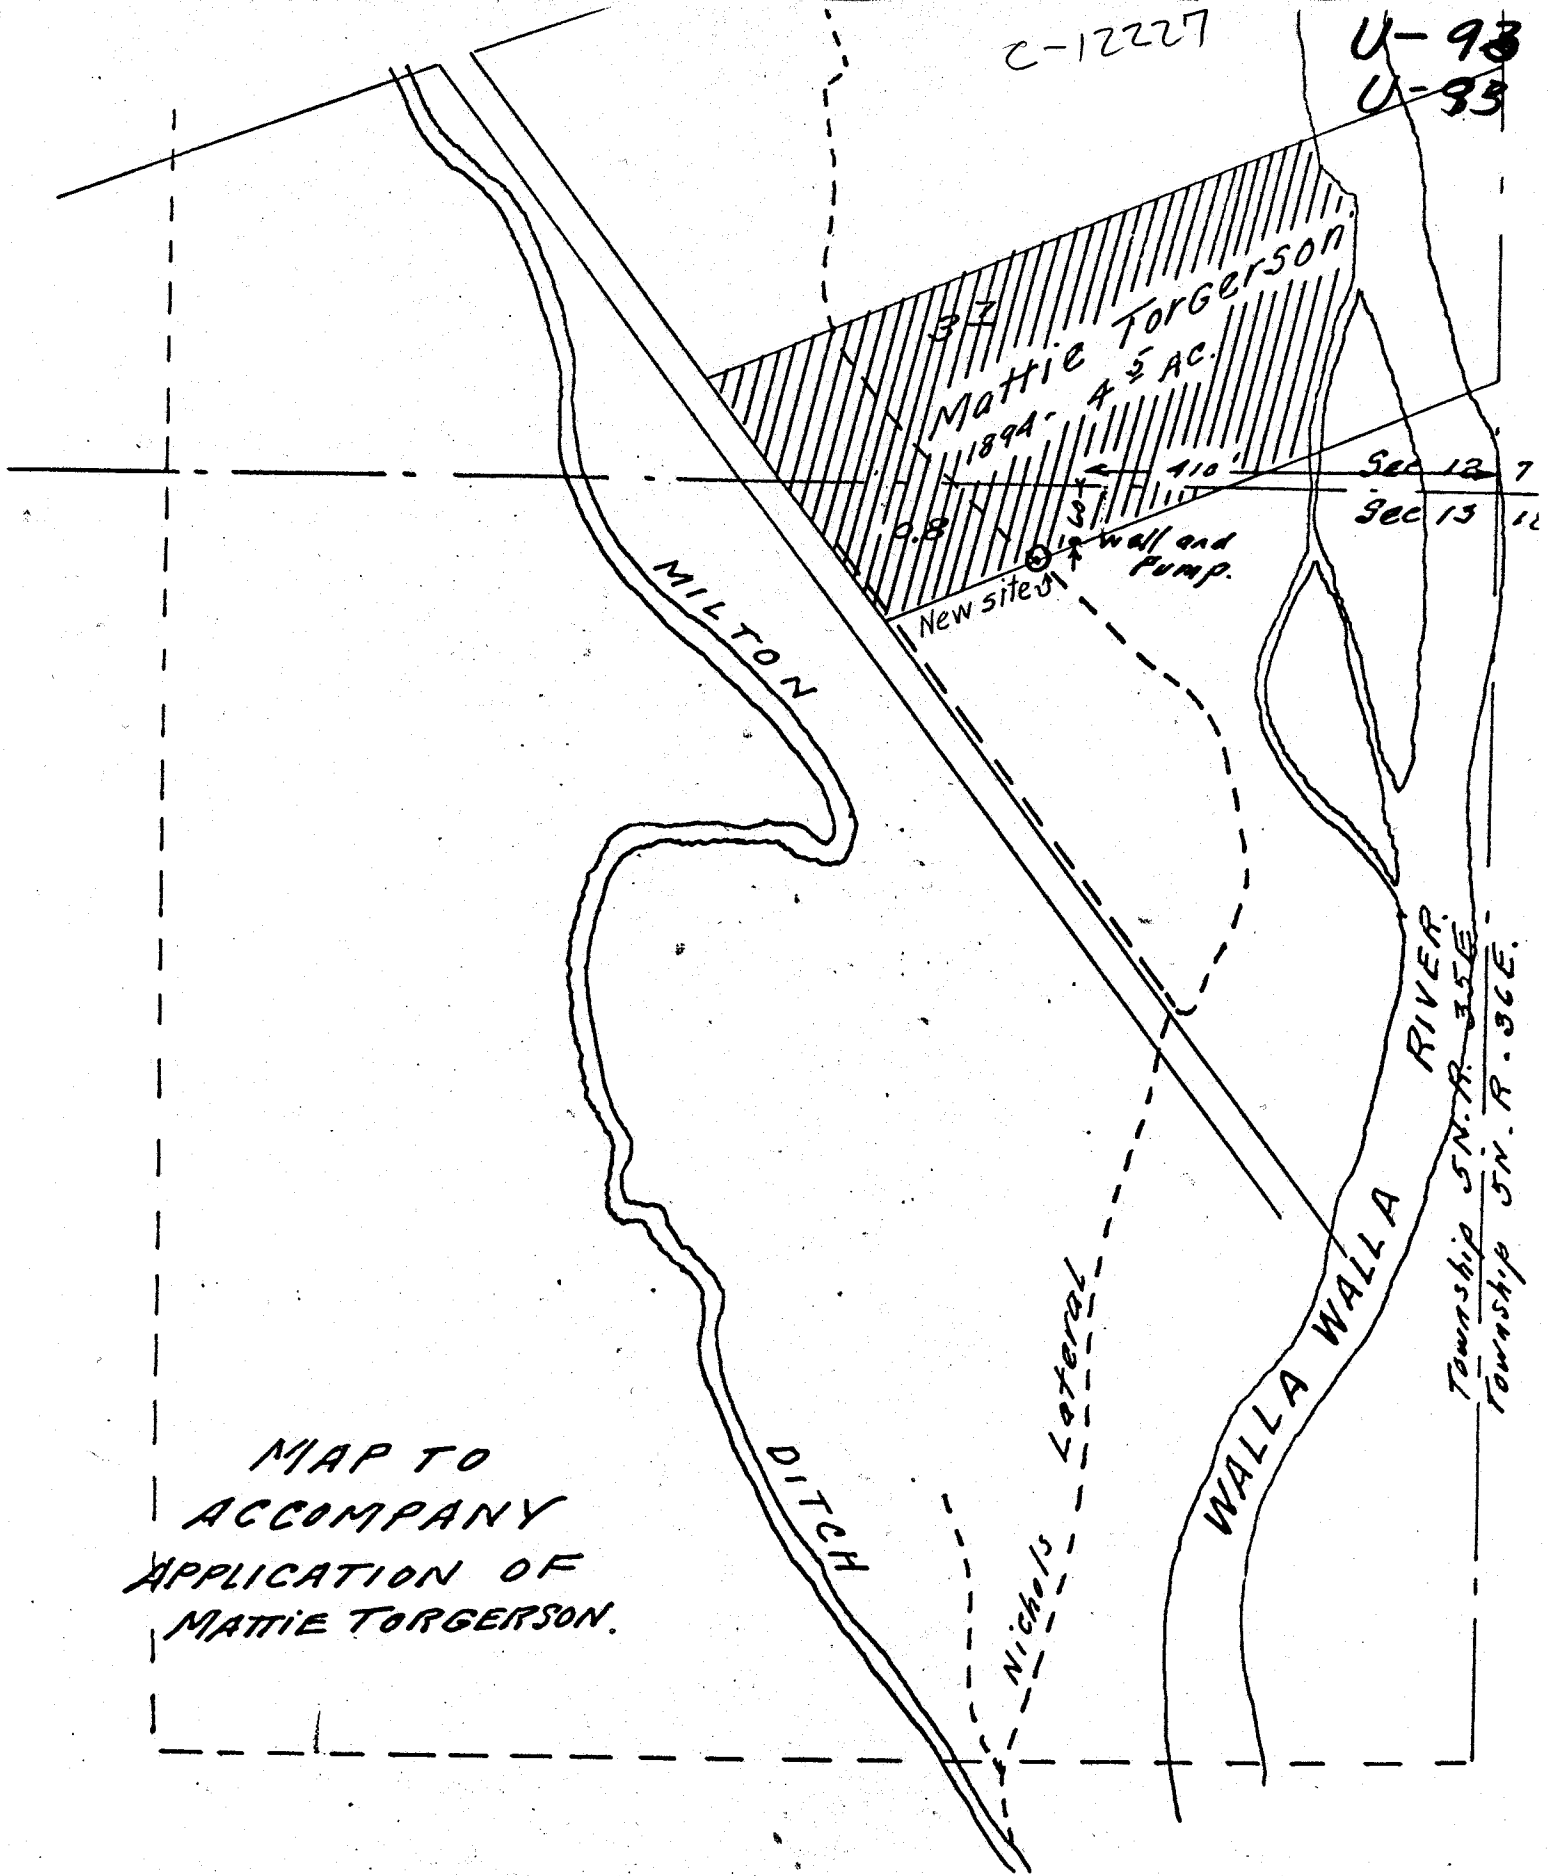

MAP TO
ACCOMPANY
APPLICATION OF
MATTIE TORGERSON.

Township 5N. R. 35E.
Township 5N. R. 36E.

App. No. U-100
Per. No. U-93

