


SECTION

C72247

TOWNSHIP 15S, RANGE 16E, W. M.

North

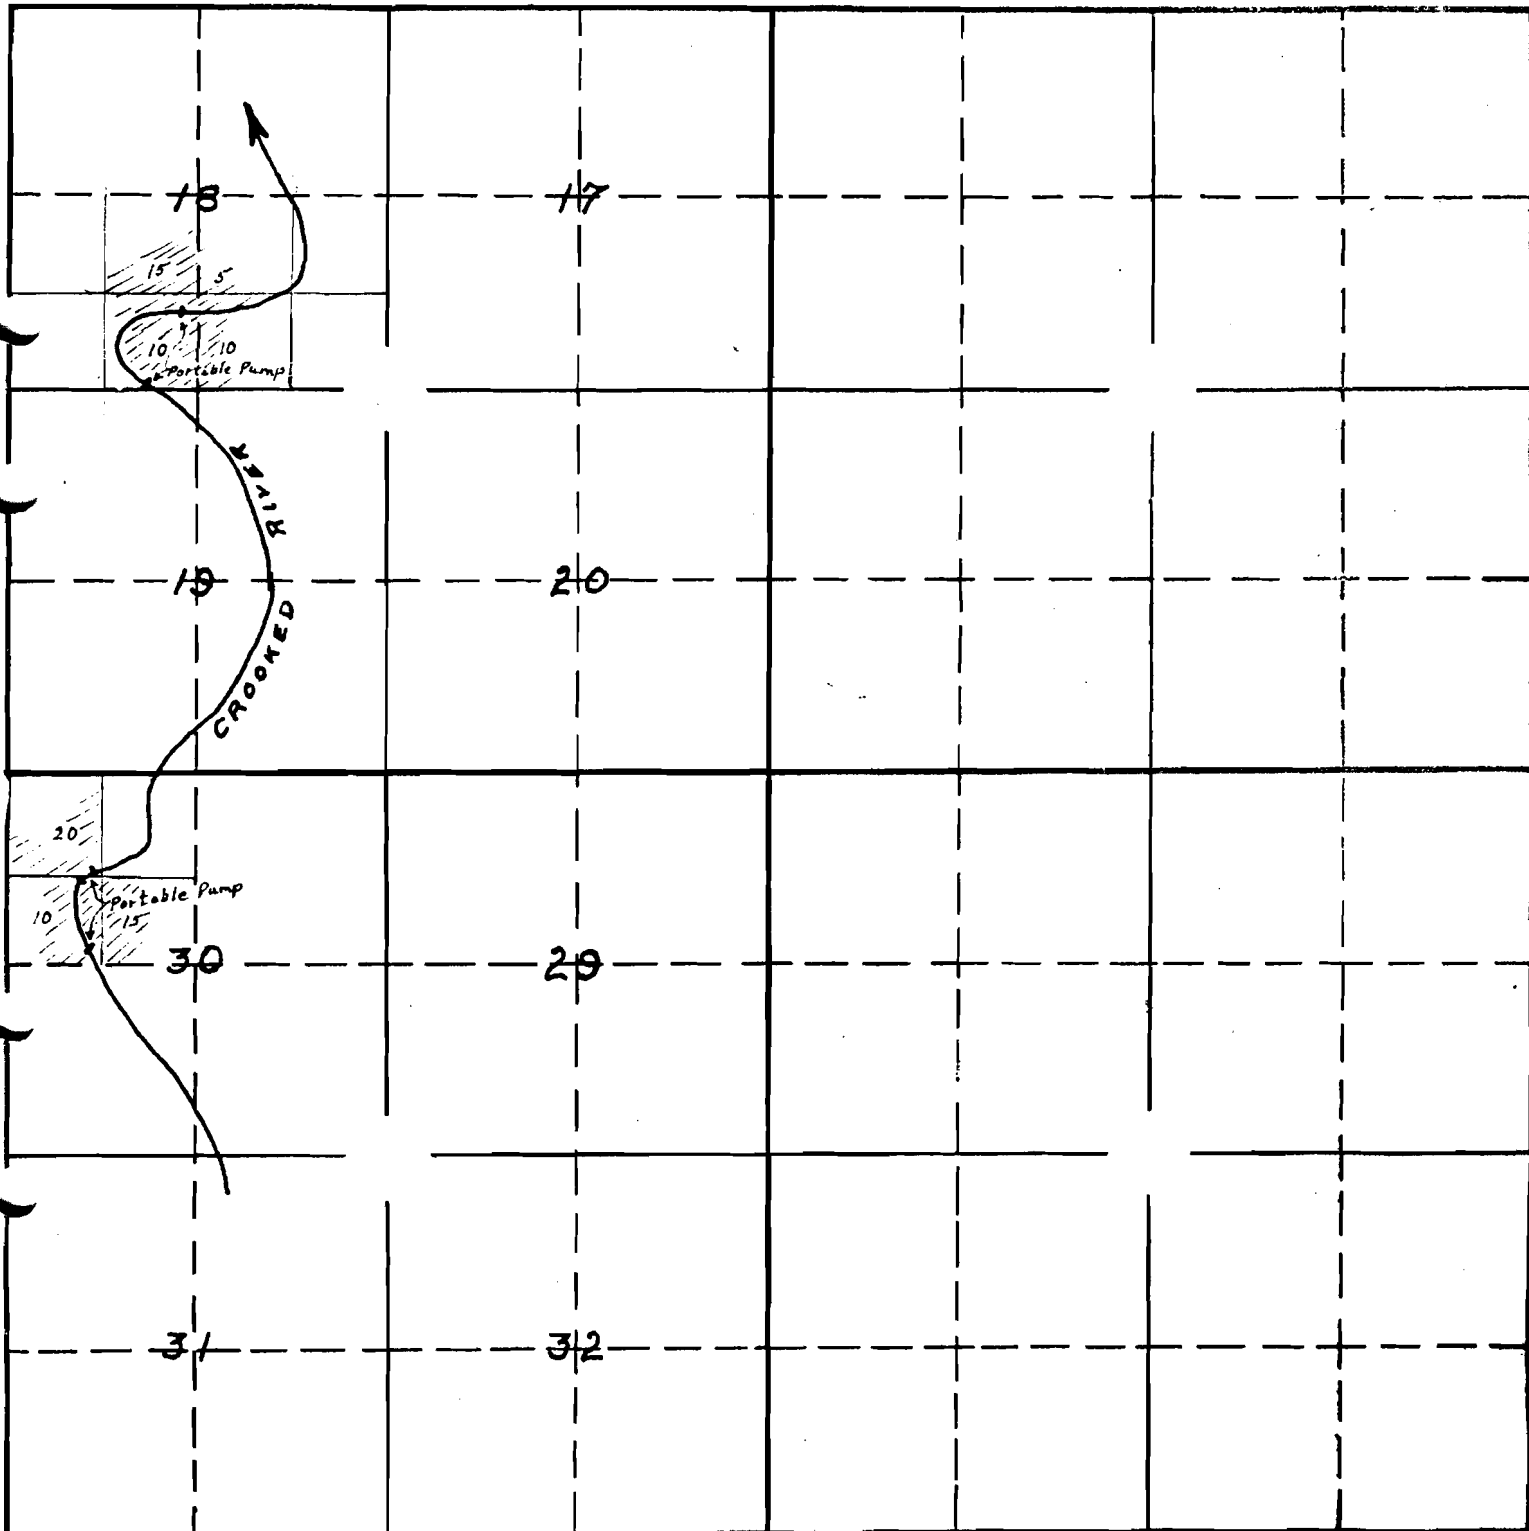

Copied from applicants sketch - 6/13/35

South

5-11-  
APPLICATION No. 15876

PERMIT No. 11726


p#

p1

TOWNSHIP 15 S, RANGE 16 E, W. M.

North

Found

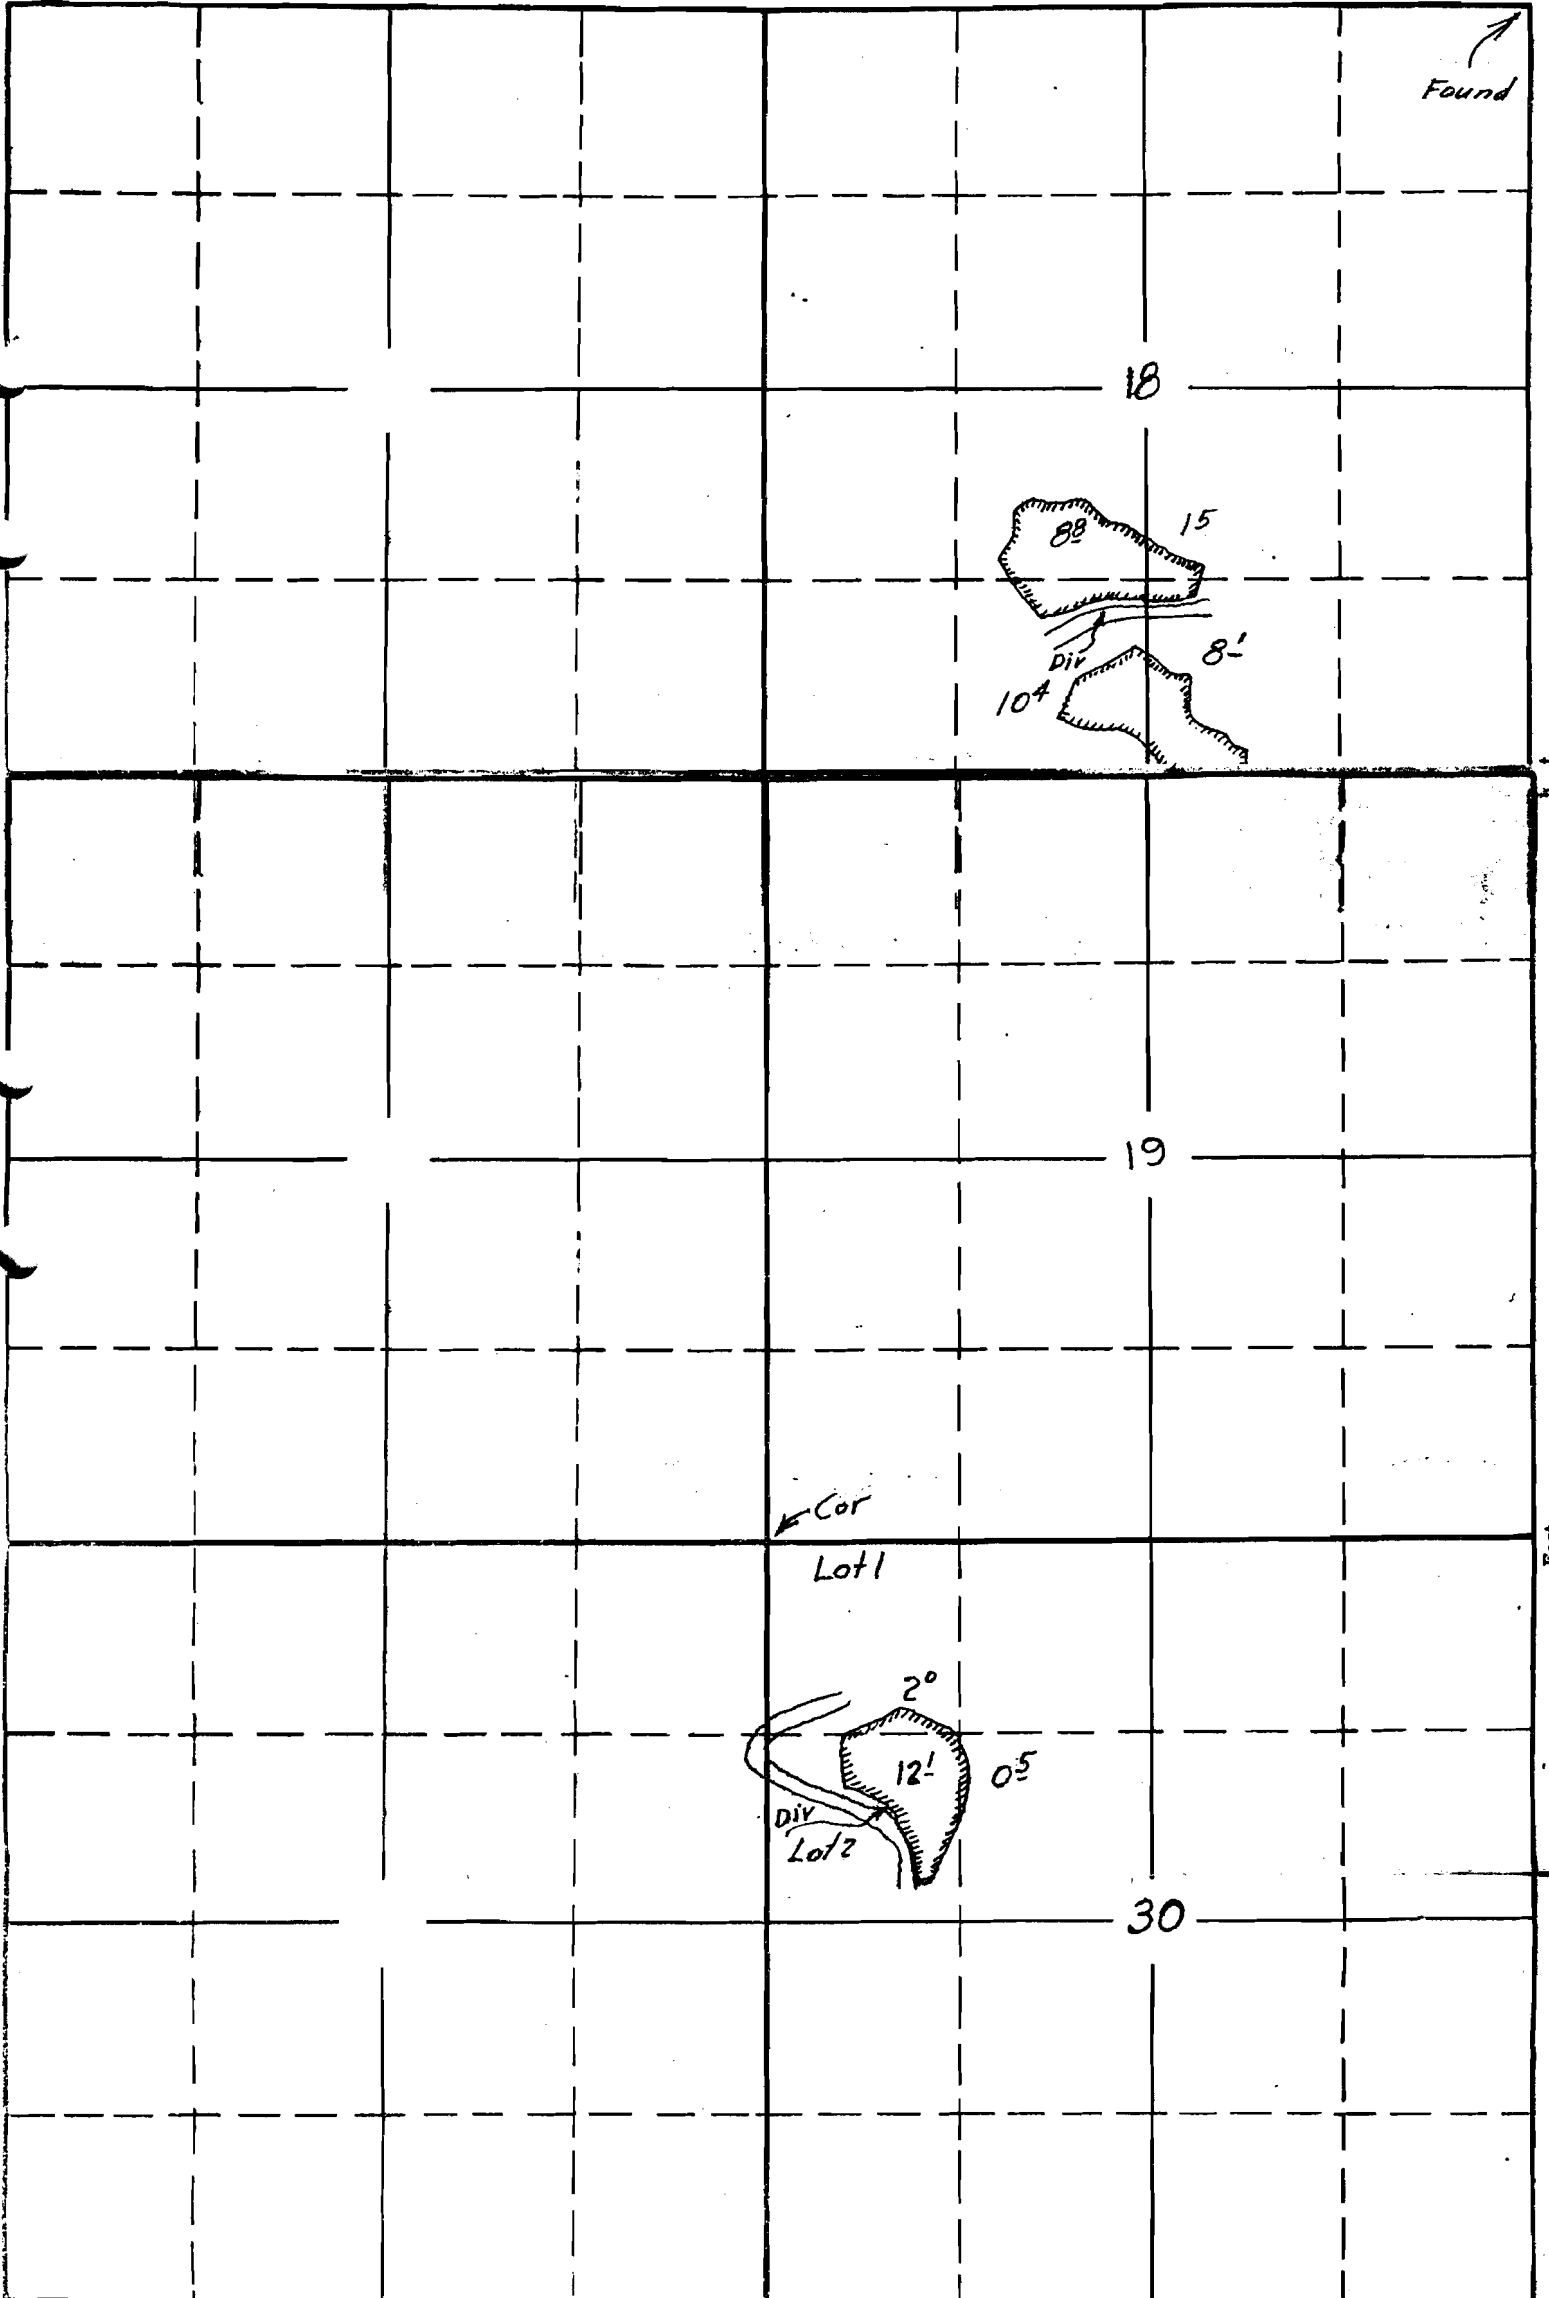

South