


11863  
C#12250

Township No. 36 S, Range No. 24, E W M Meridian.

Lake County, Oregon

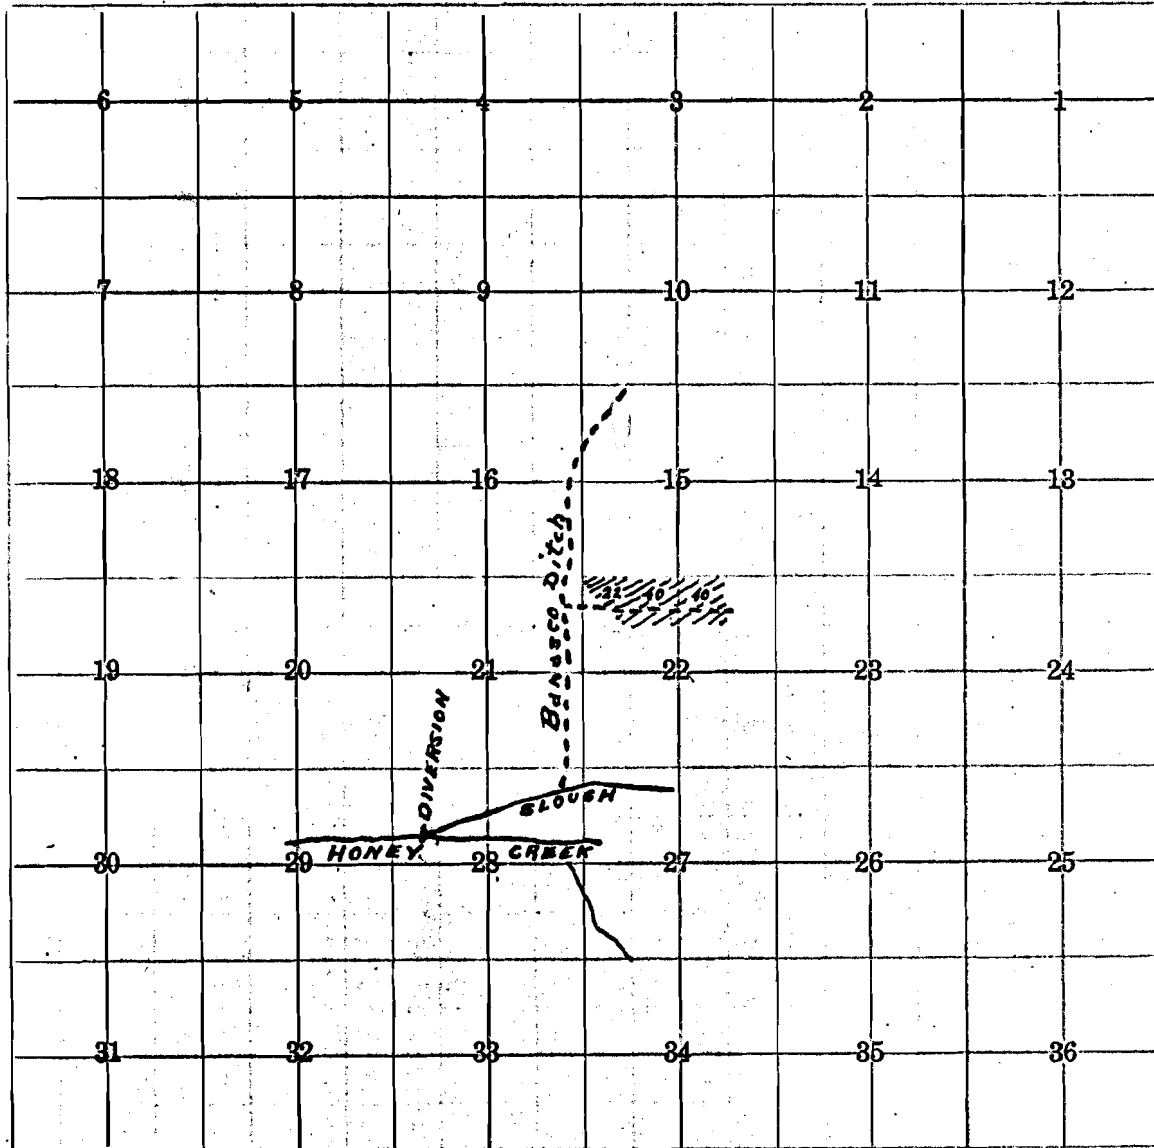

App. No. 16044  
Per. No. 11863

RECEIVED  
SEP 30 1935  
STATE ENGINEER  
SALEM, OREGON

RECEIVED  
SEP 16 1935

36-24 ✓

STATE ENGINEER  
SALEM, OREGON