

SECTION


10

12311

C# 12266

TOWNSHIP 40 S, RANGE 19 E, W. M.

North

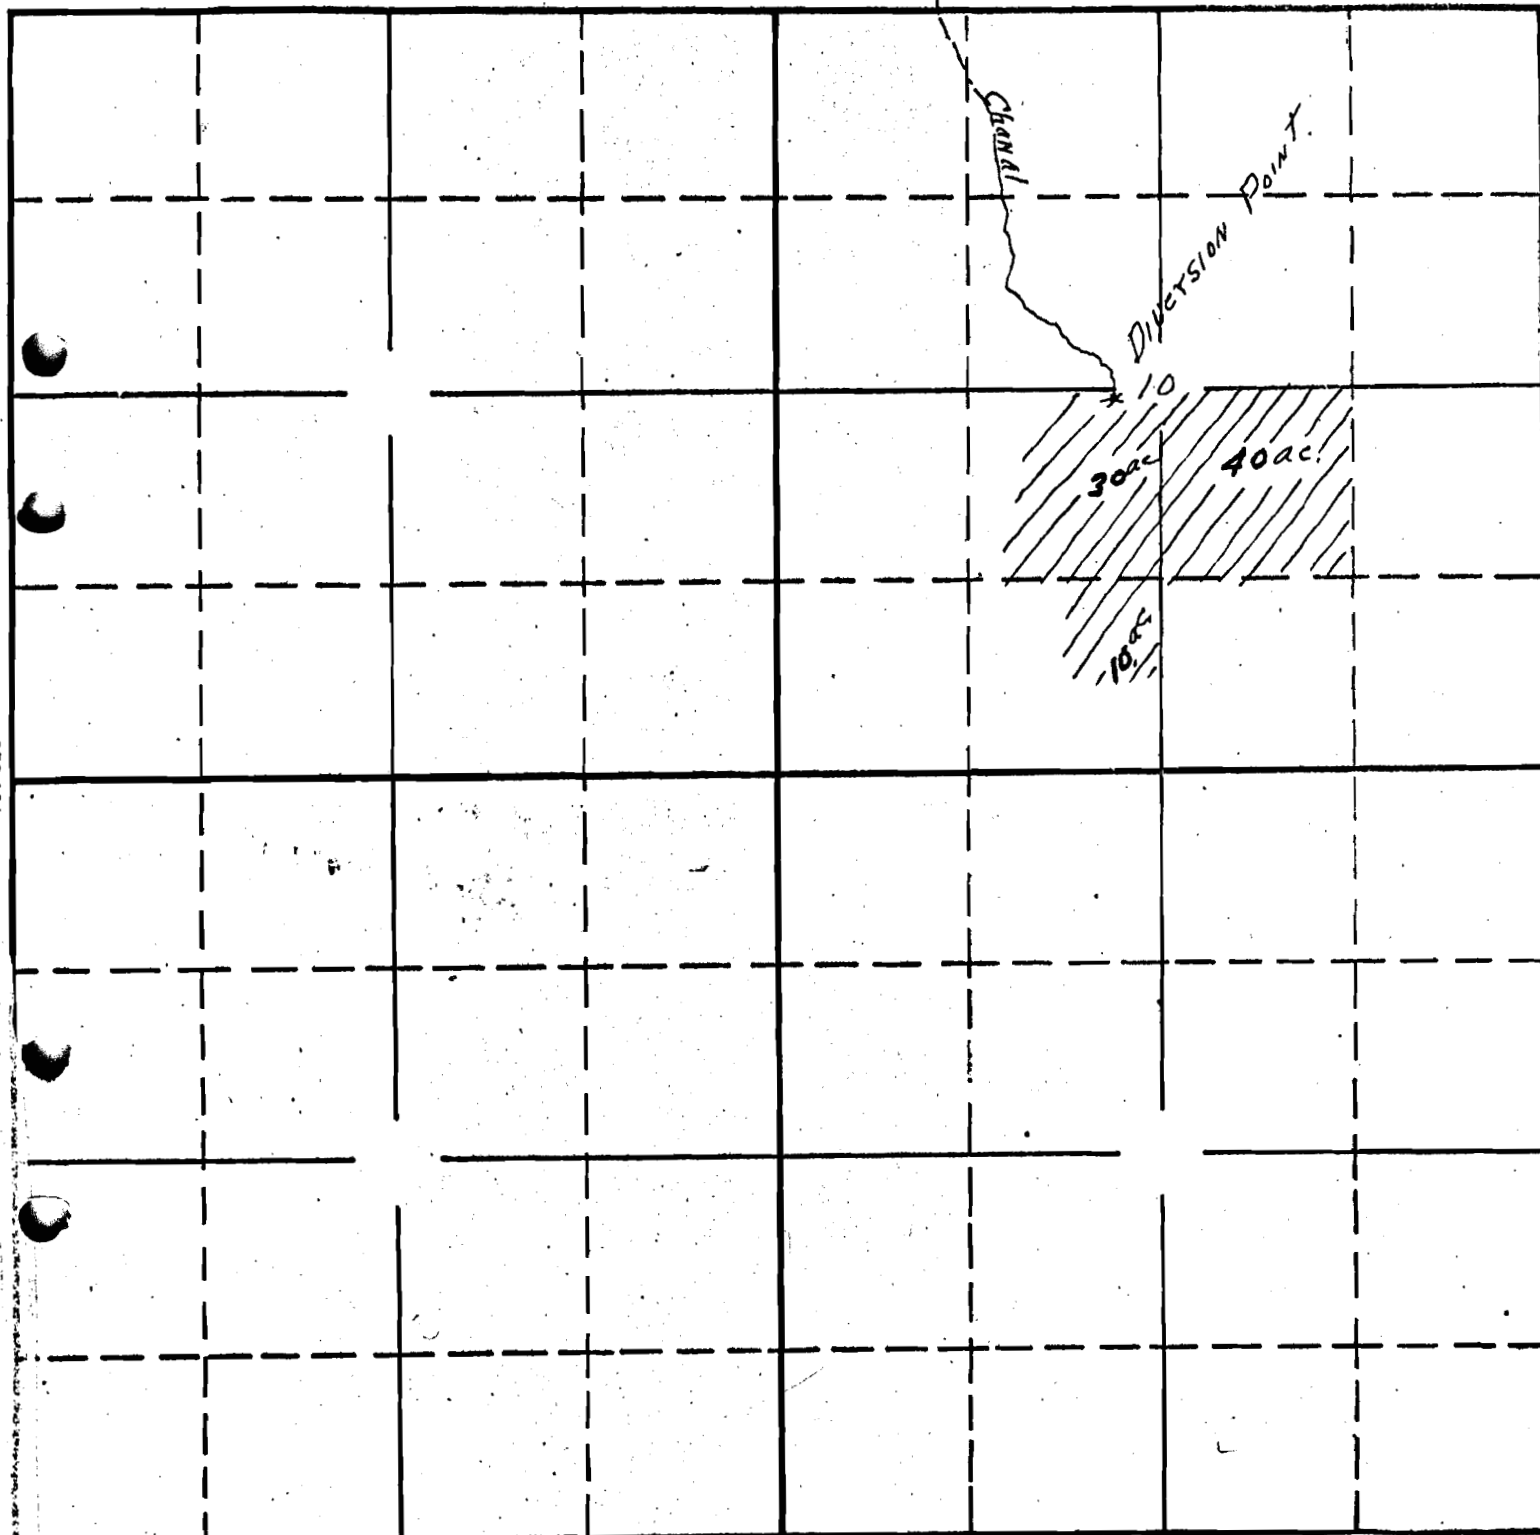

South

APPLICATION No. 16514

PERMIT No. 12311

40-190