


SECTION

13 & 14

Per 12379
12267

TOWNSHIP 15, RANGE 21E, W. M.

North

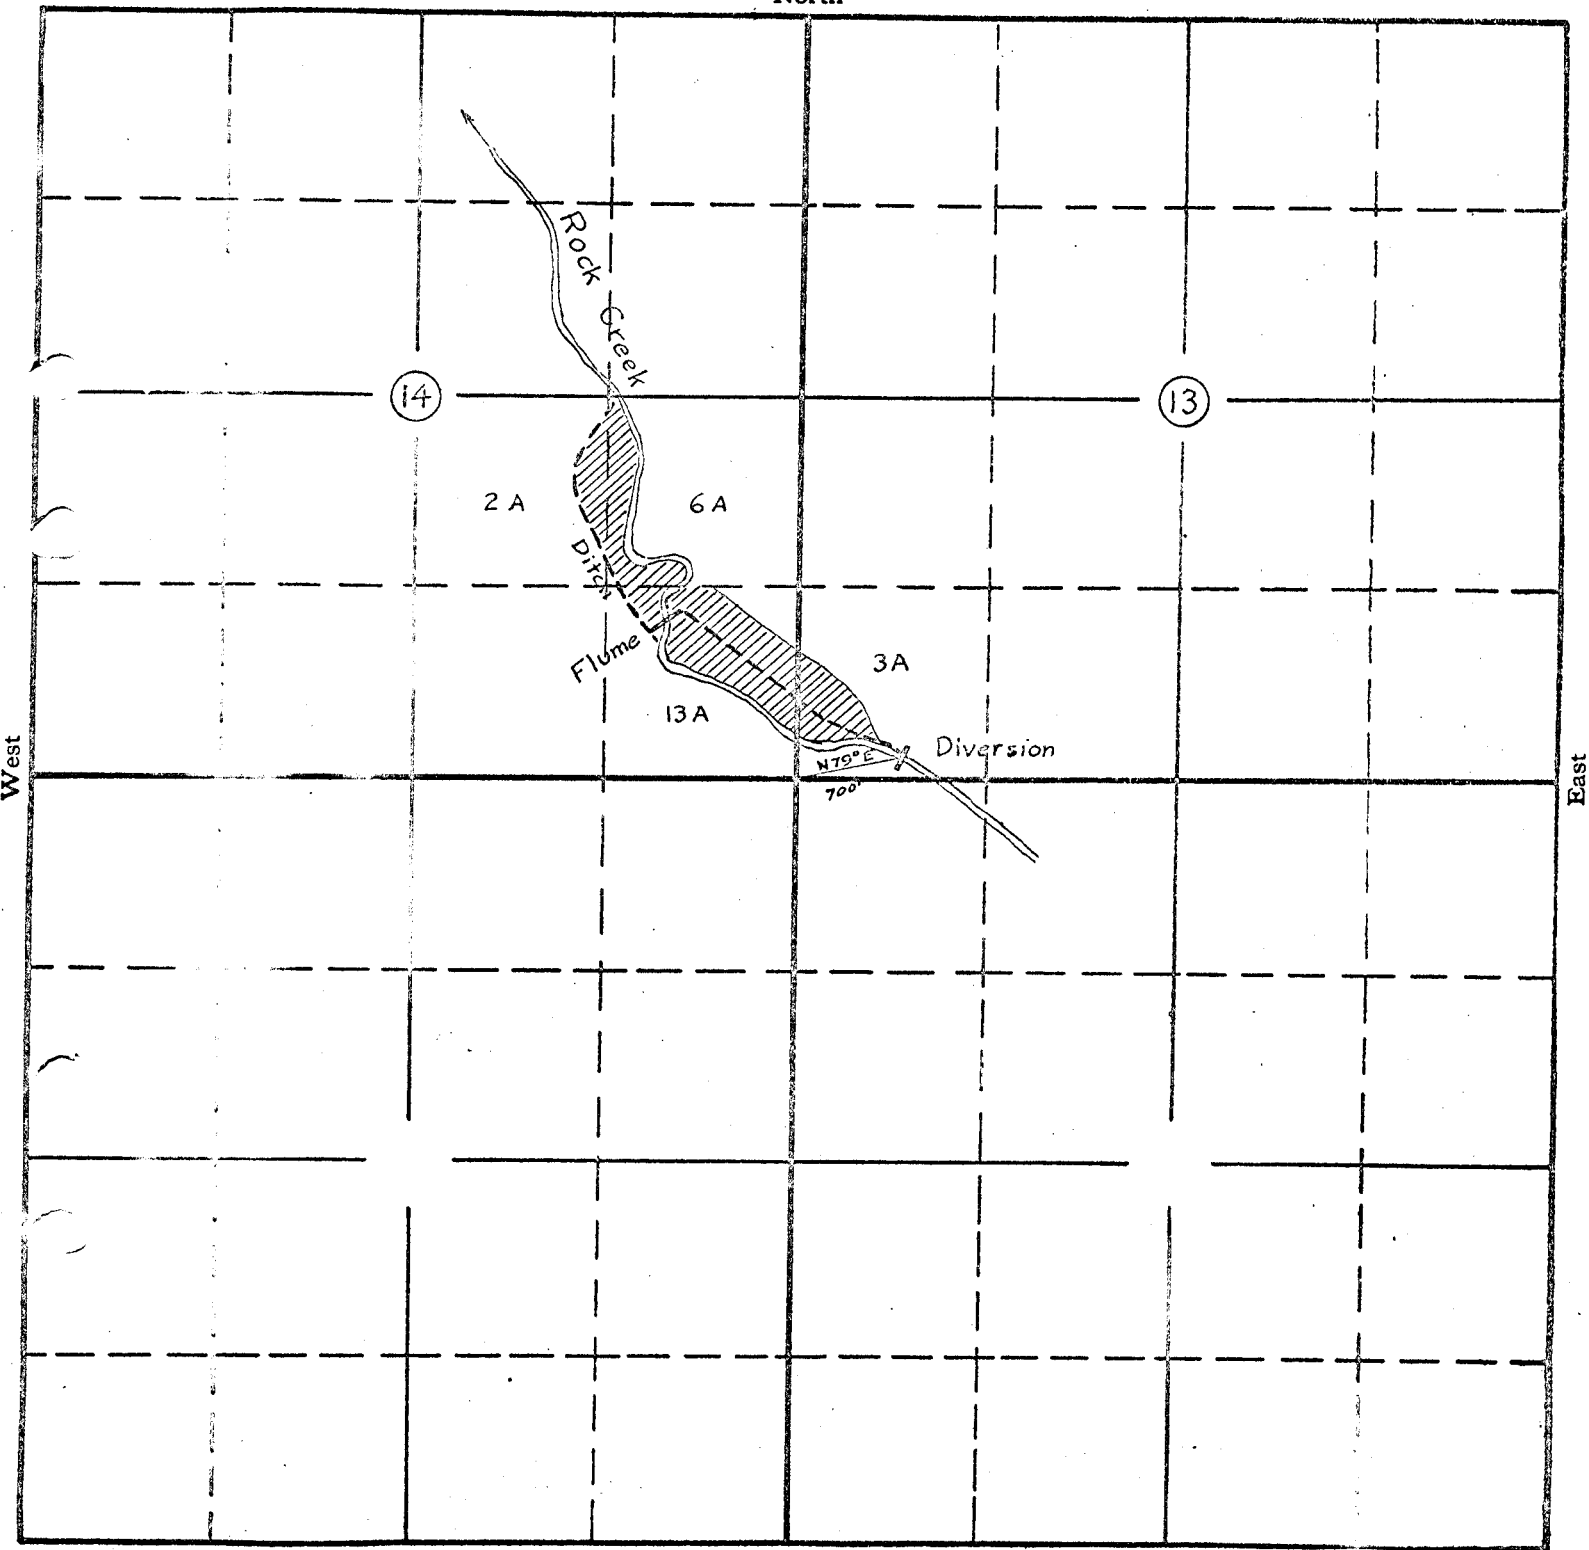

South

6-30-16593-01
APPLICATION No. 16593
PERMIT No. 12379