


SECTION

TOWNSHIP 45, RANGE 3E, W. M.

North

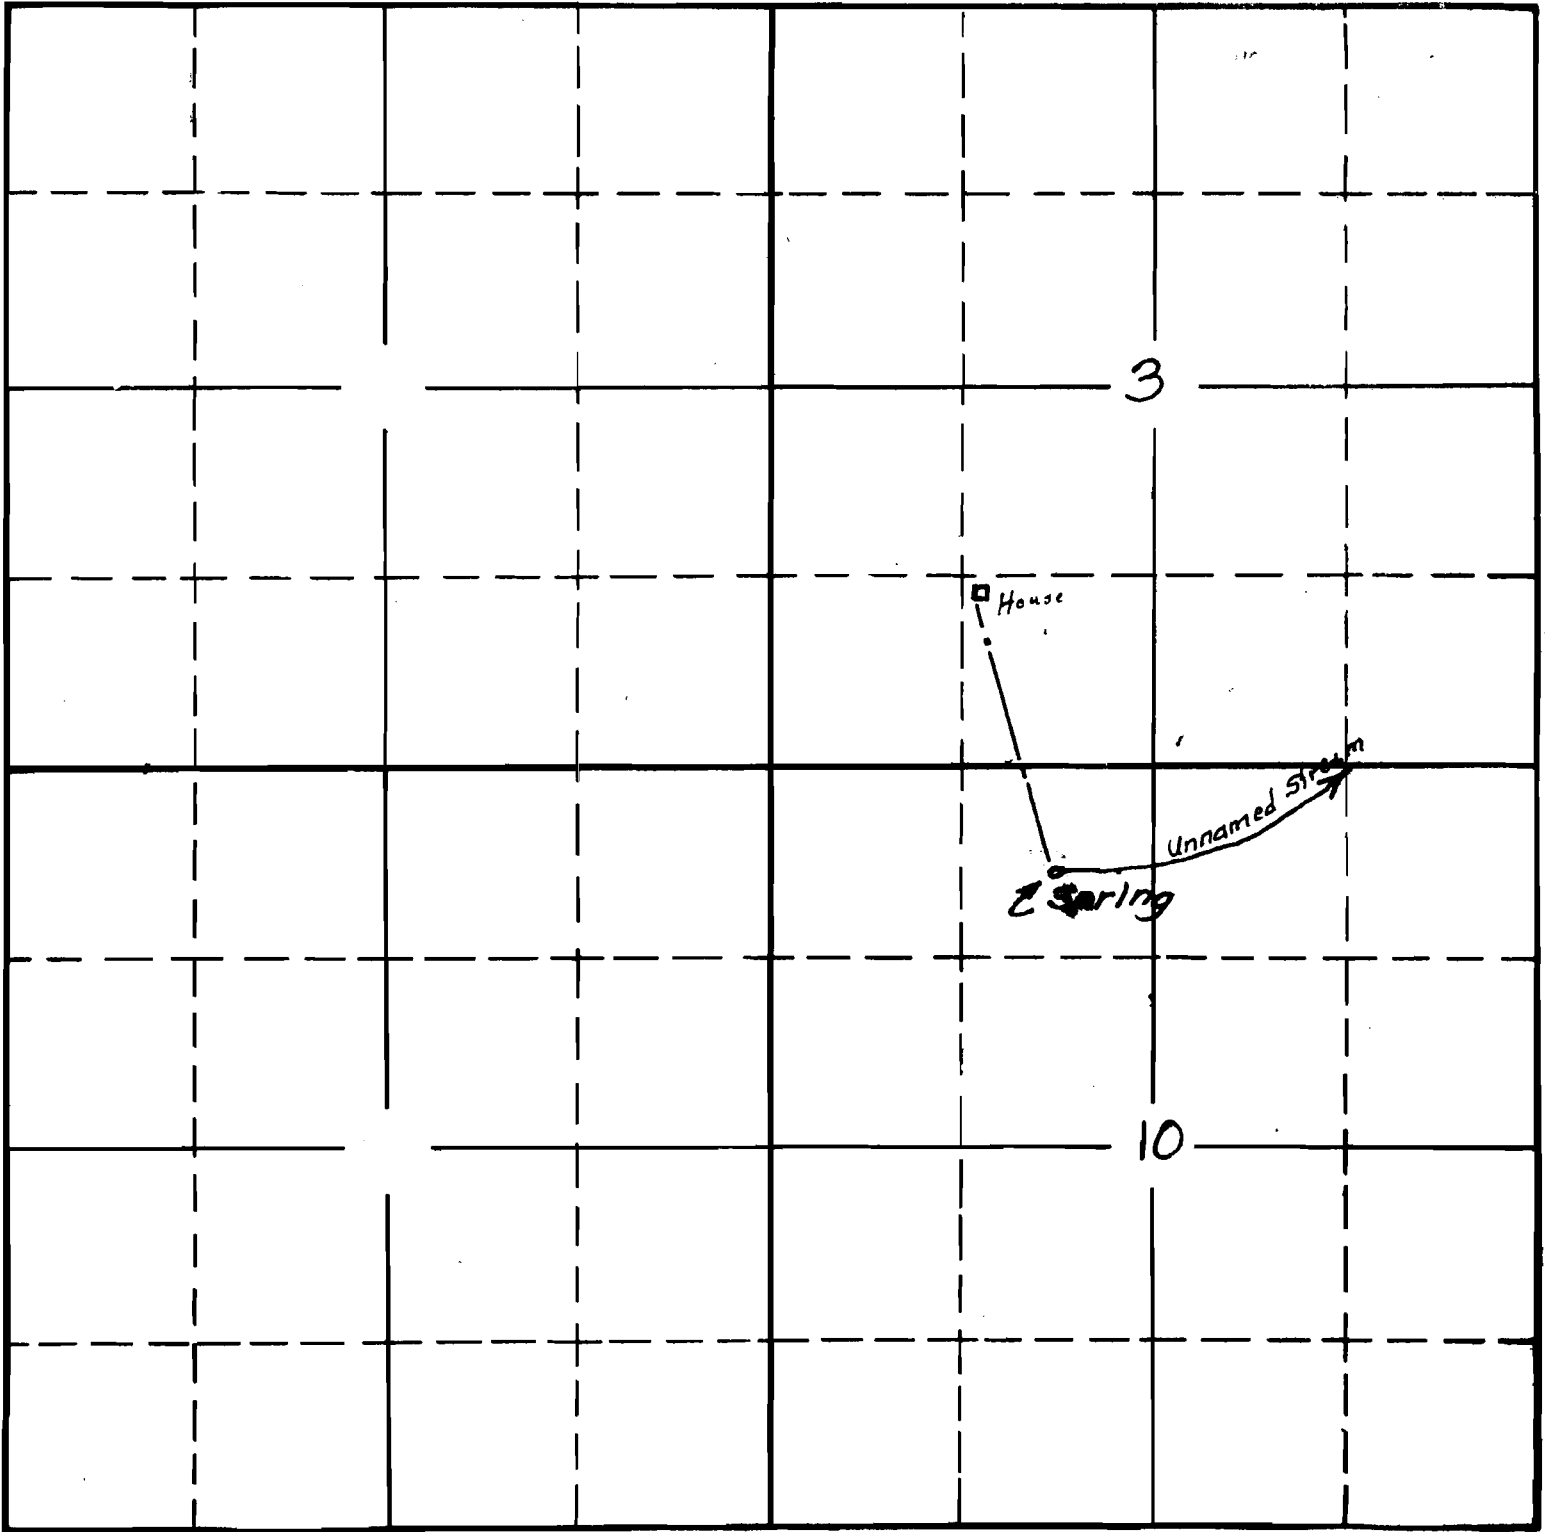

West

East

South

2-10-16861-DR
APPLICATION No. 16861
PERMIT No. 12621