


C1228

4034

OFFICE OF STATE ENGINEER
RECEIVED
DEC 27 1916
SALMON • • OREGON

MAP of SPRING CREEK

4804

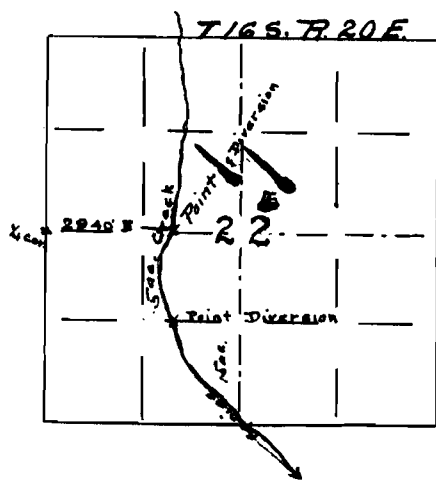

No. 4034
No. 2308

4034