


SECTION

TOWNSHIP 46, RANGE 5 W, W. M.

North

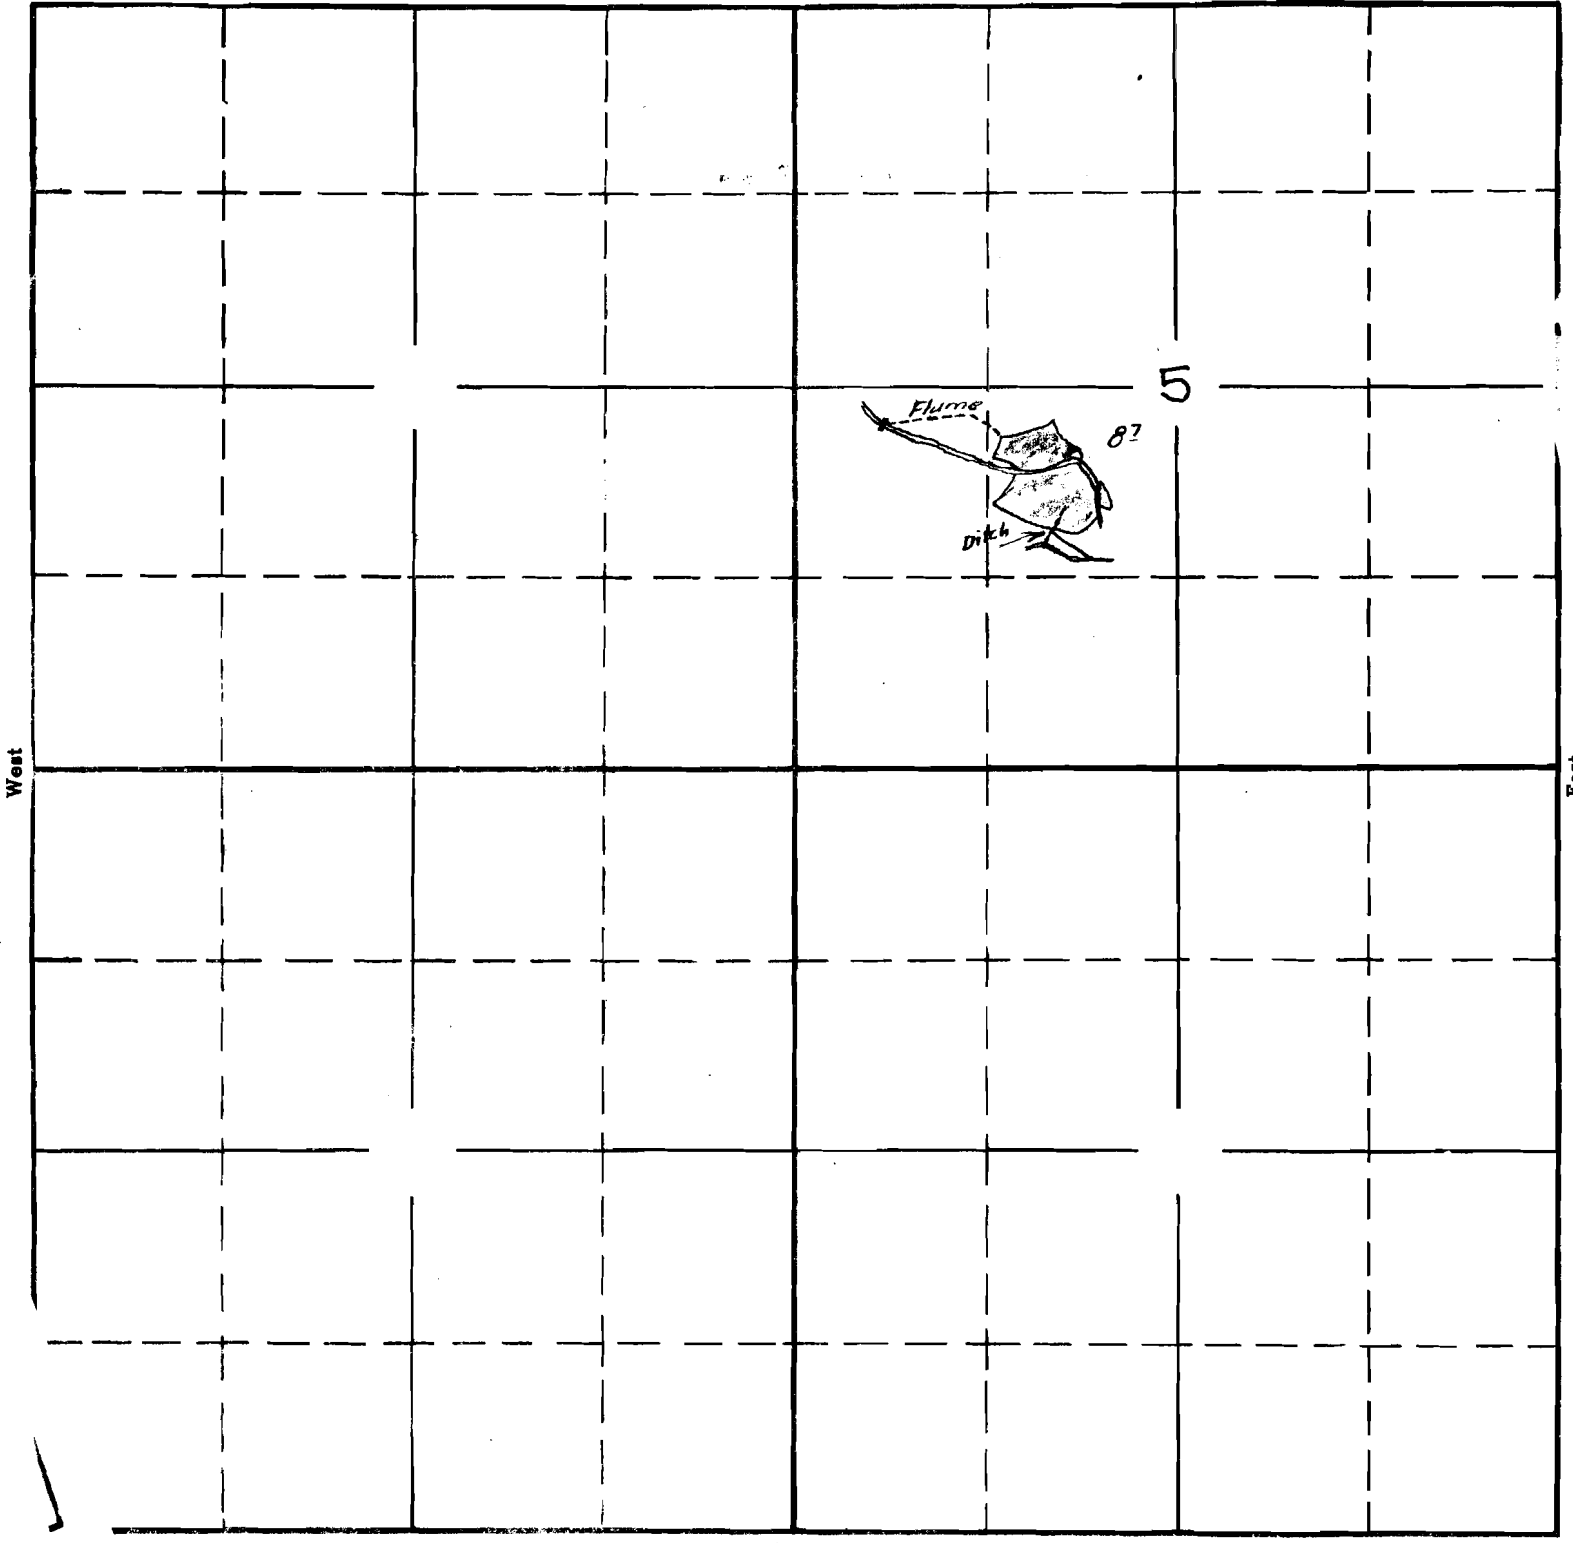

South

APPLICATION No. 12387
PERMIT No. 8744