


R. 24 E. Scale 1 in. = 1000'

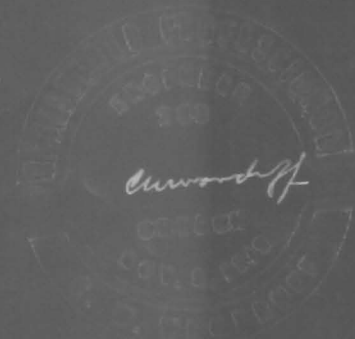

I, C.W. Woodruff, of Prineville, Ore., do hereby certify that this map was made from notes taken during an actual survey, made under my immediate supervision on June 20th 1935 and that it correctly represents the works described in the accompanying application together with location of streams and other ditches in the immediate vicinity

Ore. No. _____

C.W. Woodruff
Registered Professional Engineer

Date of Registration.

App. No. 15934

Per. No. 11757
(Lands in Sec. 16 only)

App. No. 15935

Per. No. 11758
(Lands in Sec. 22 only)