


10

11

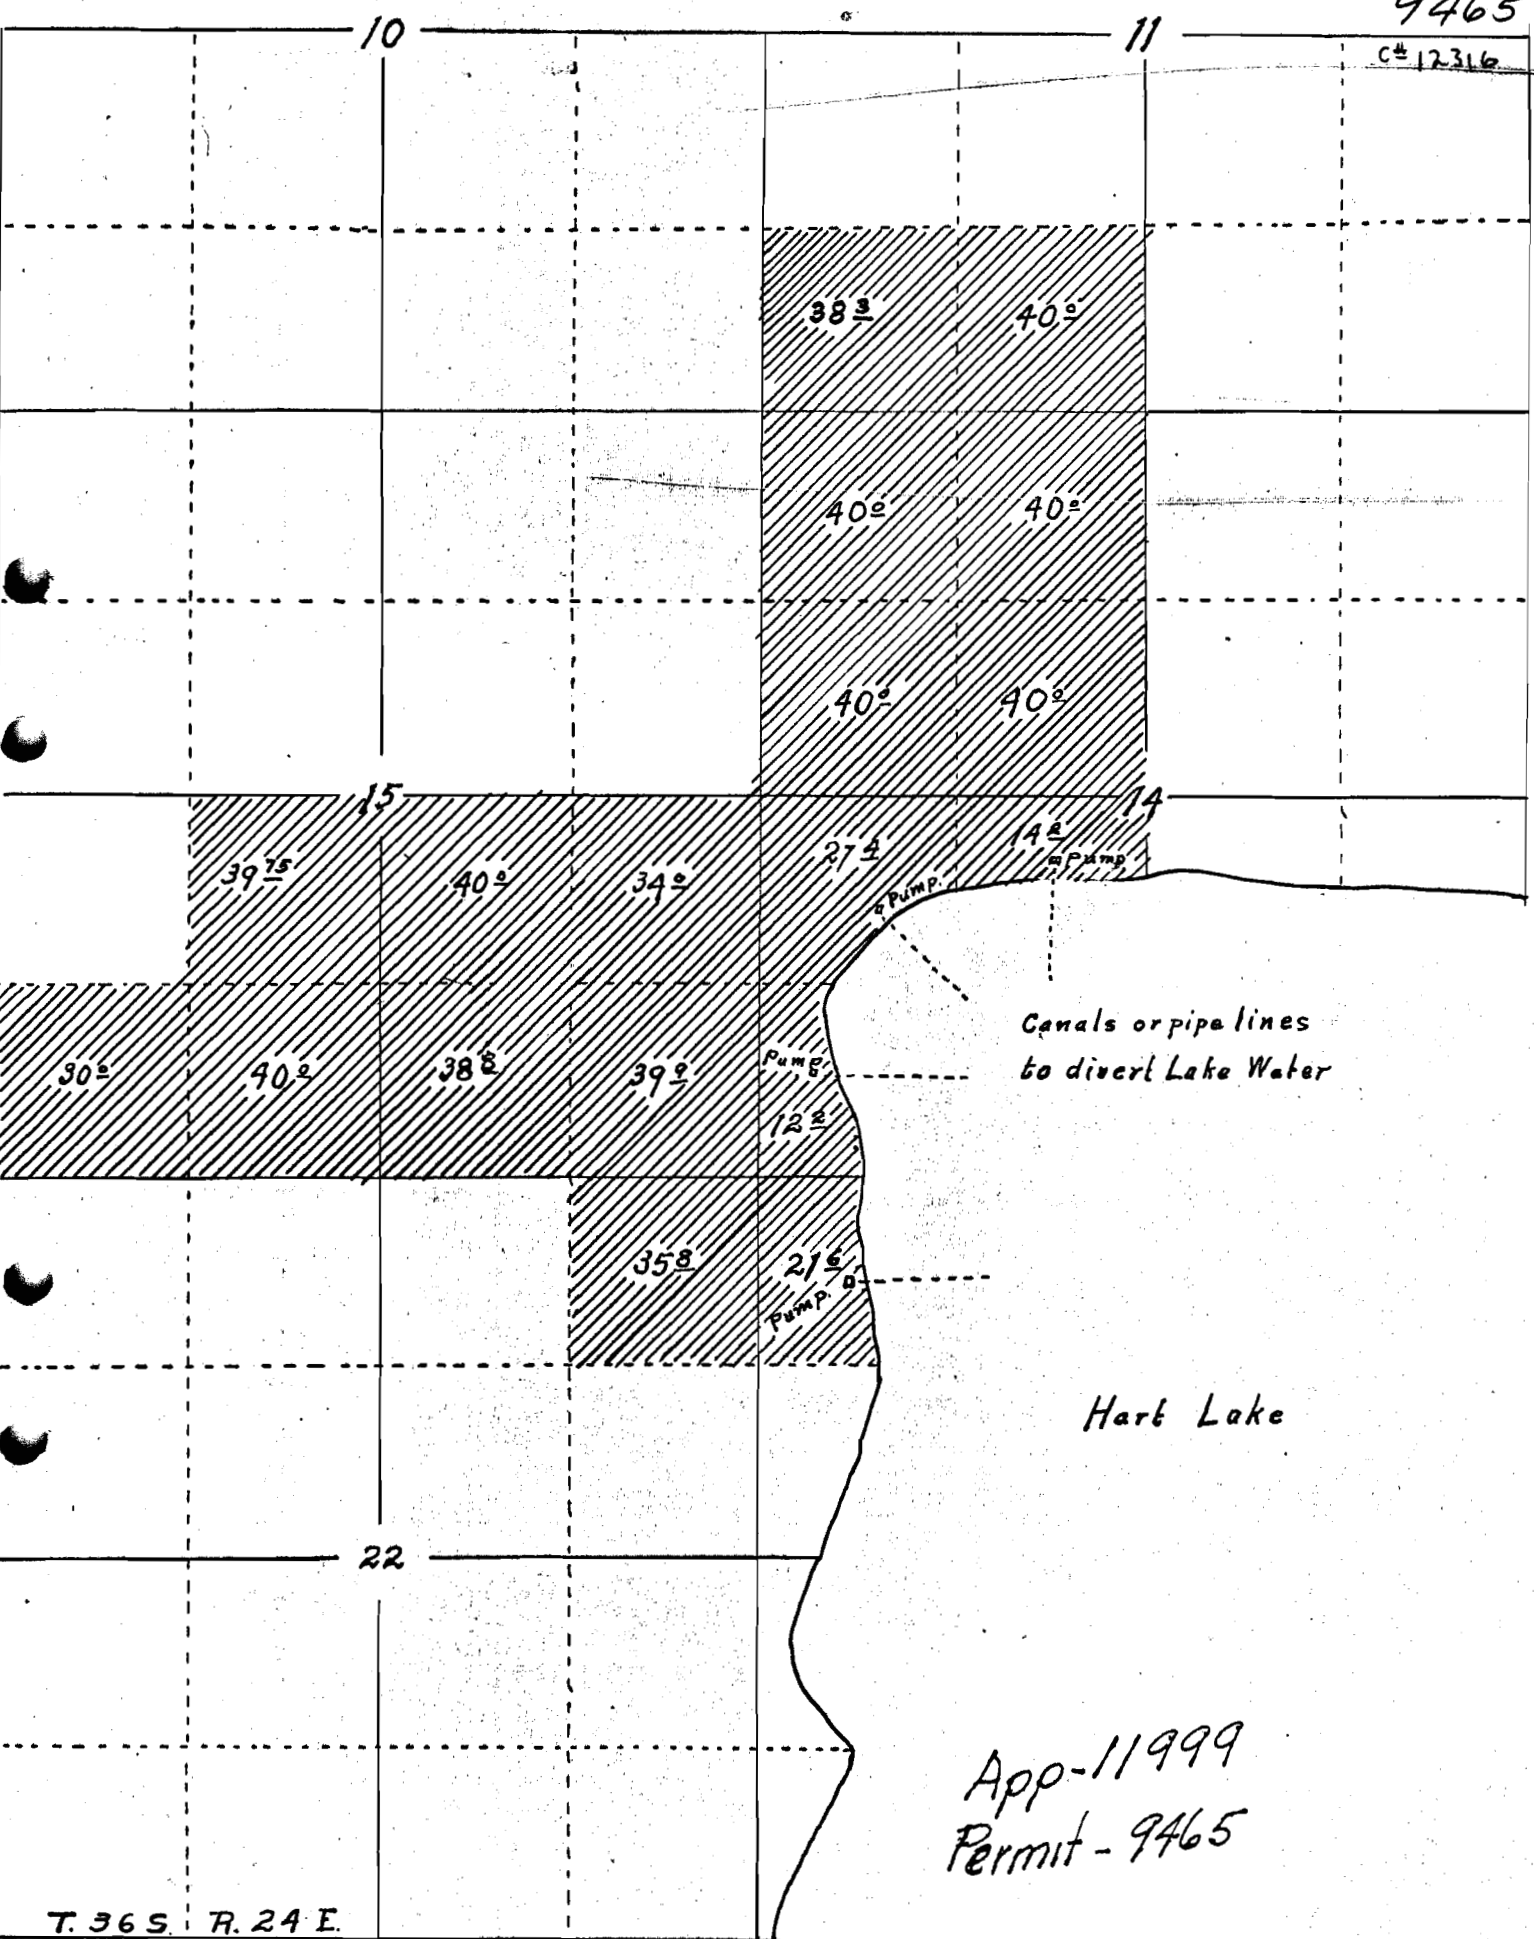

T. 36 S. R. 24 E.

Canals or pipe lines
to divert Lake Water

Hart Lake

App-11999
Permit-9465

I, Percy A. Cupper, of Salem, Oregon, do hereby certify that this map was made from map prepared from notes taken during an actual survey made under my direction and that it correctly represents the works described in the accompanying