


SECTION

TOWNSHIP 11S., RANGE 7W., W. M.

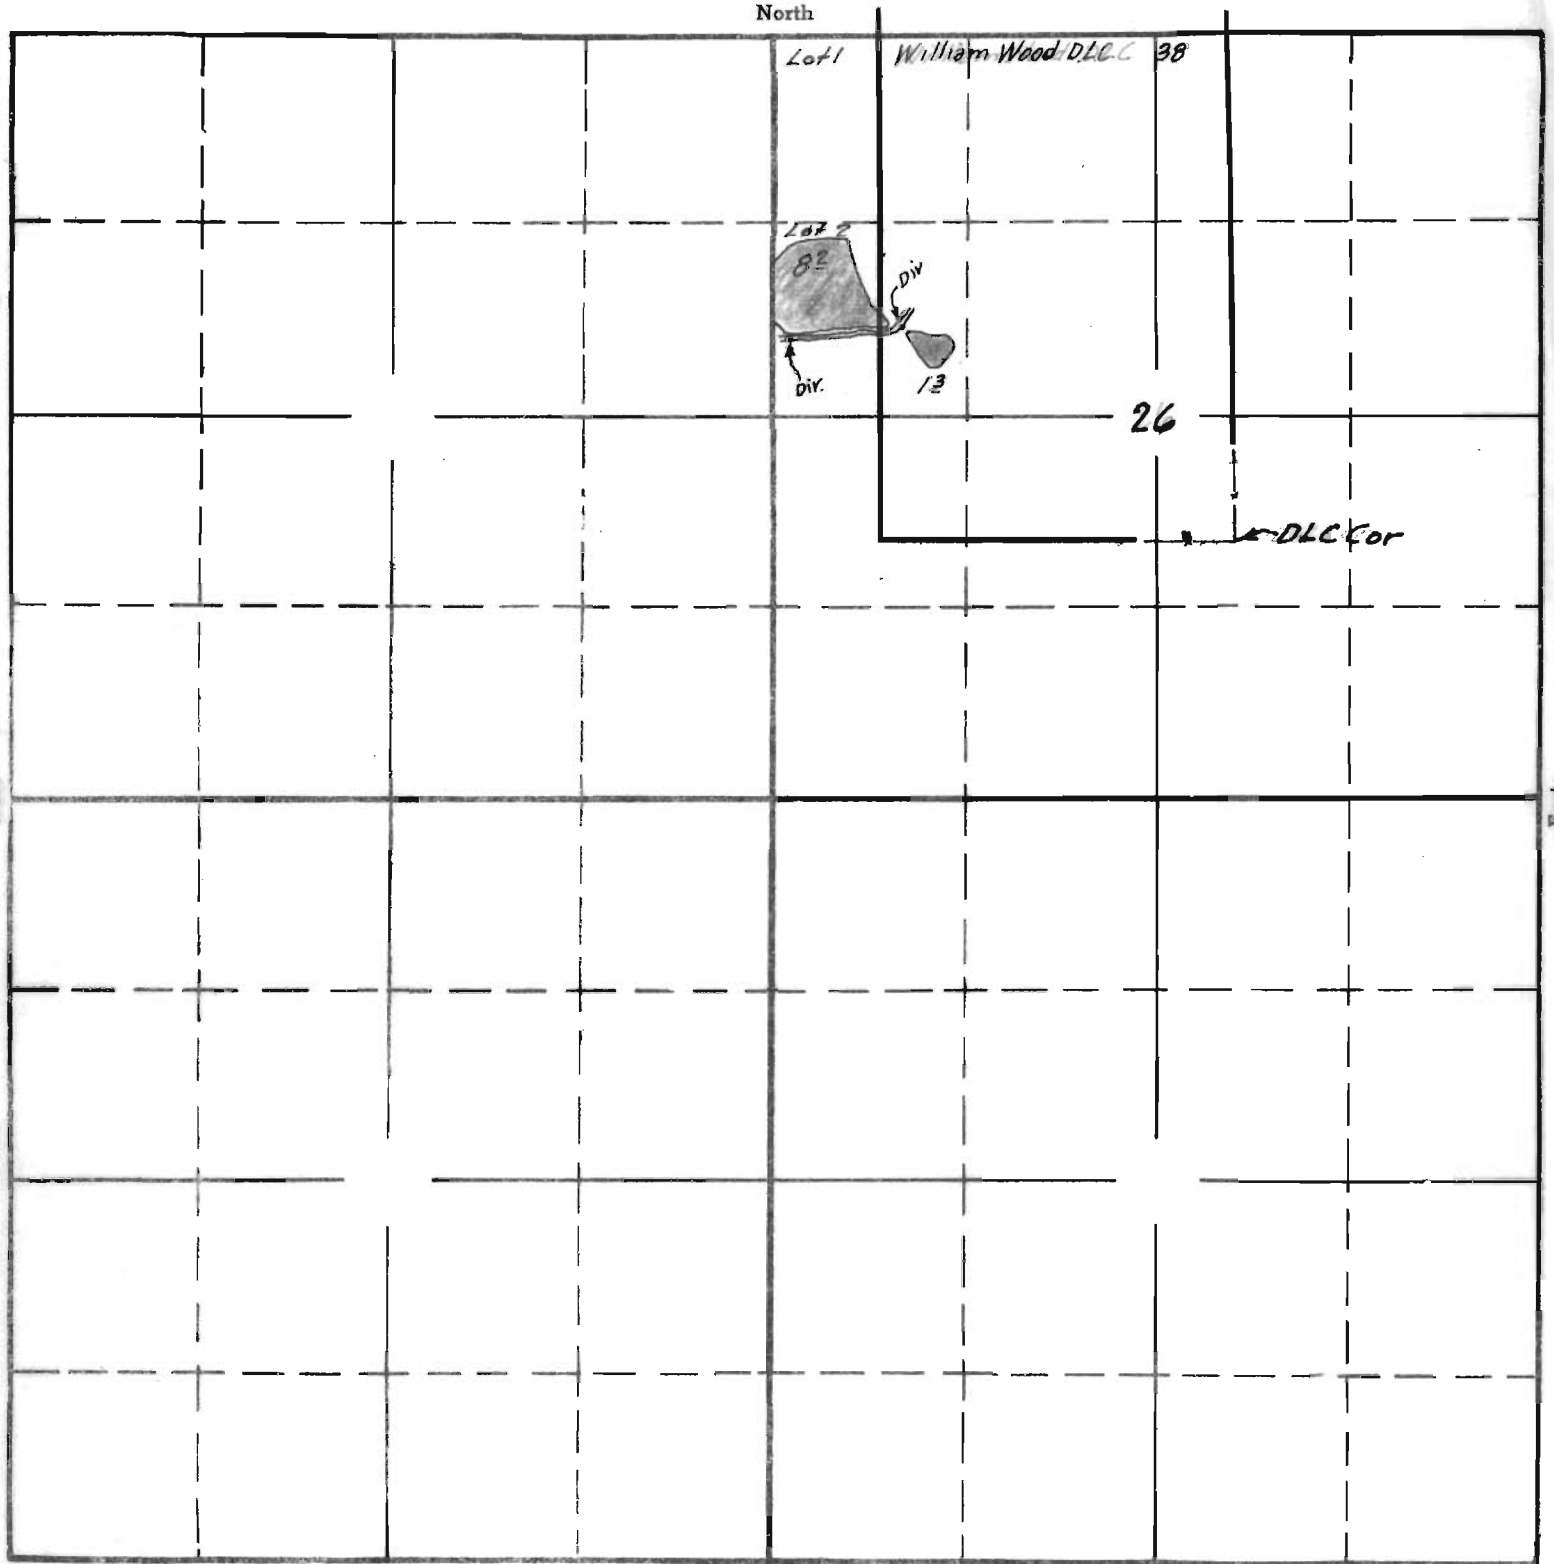

Surveyed Apr 19 1934
C.A.G.


South

APPLICATION No. 14821
PERMIT No. 10774

SECTION

TOWNSHIP 11S, RANGE 7W, W. M.

North

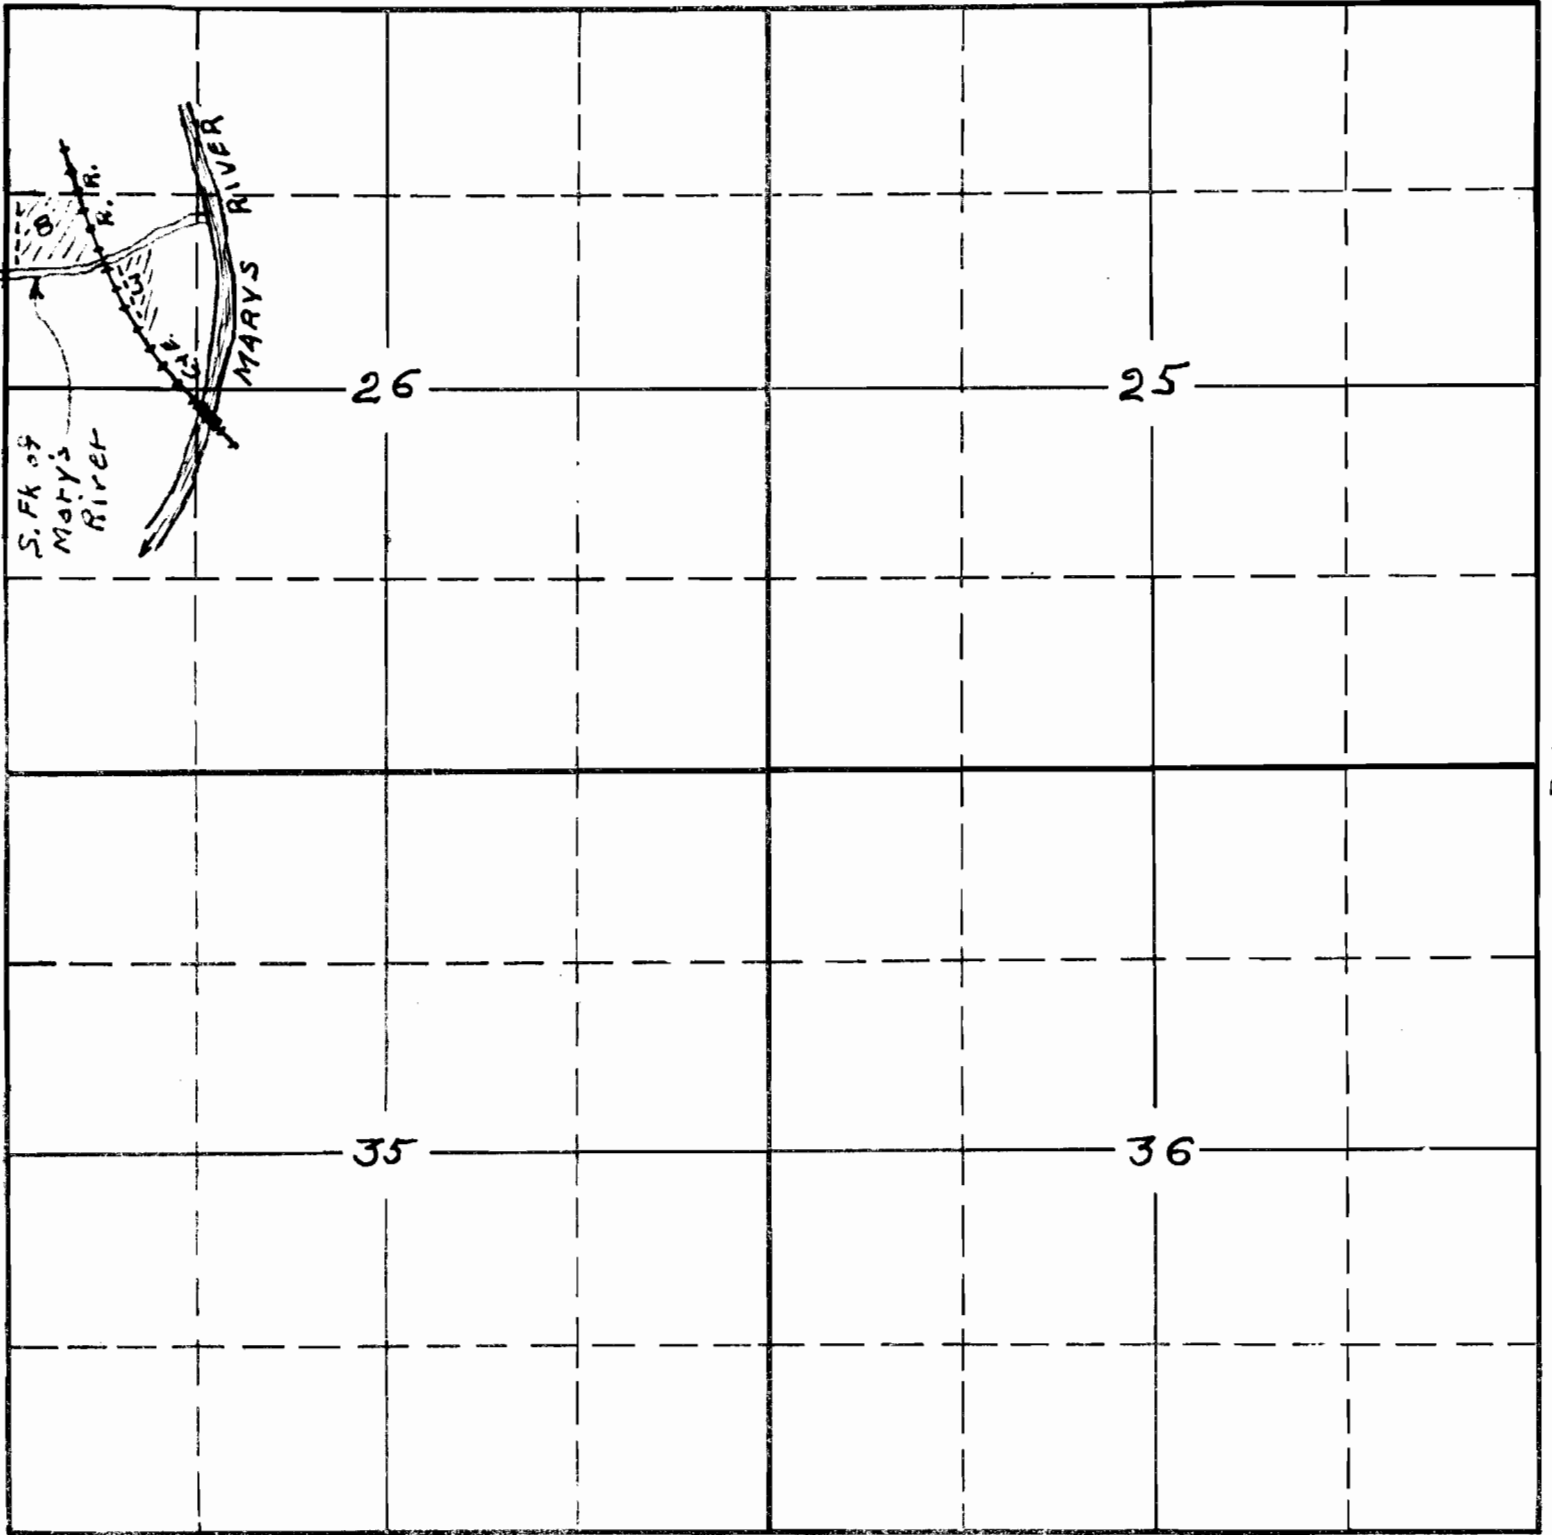

South

APPLICATION No. 14821
PERMIT No. 10774