


TOWNSHIP 35 , RANGE 2E , W. M.

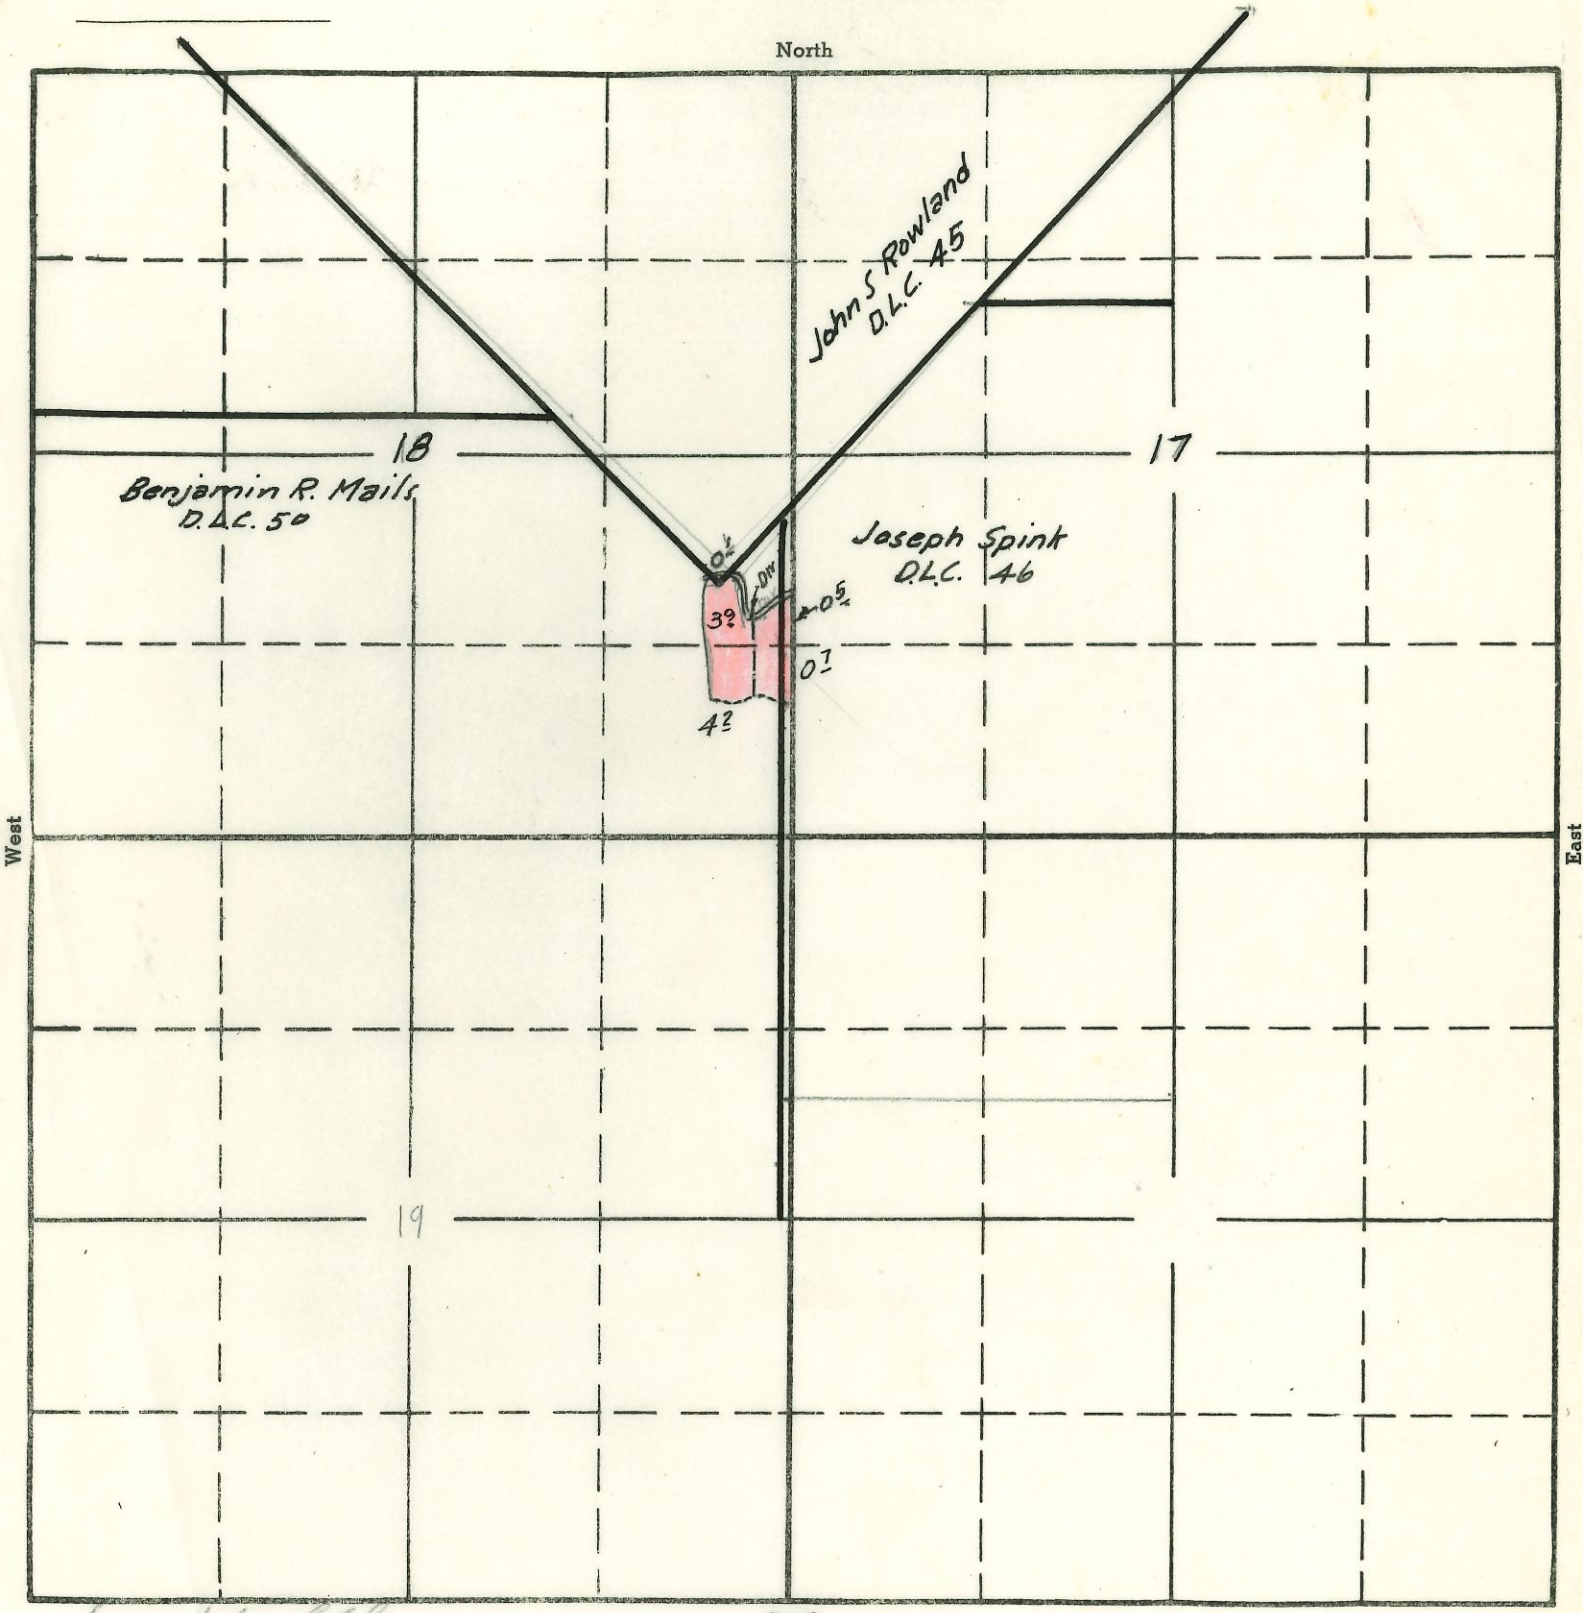

Surveyed by C.C.B.
Apr 24 1939

APPLICATION No. 15013
PERMIT No. 10943