


TOWNSHIP 7 N, RANGE 11 E, W. M.

North

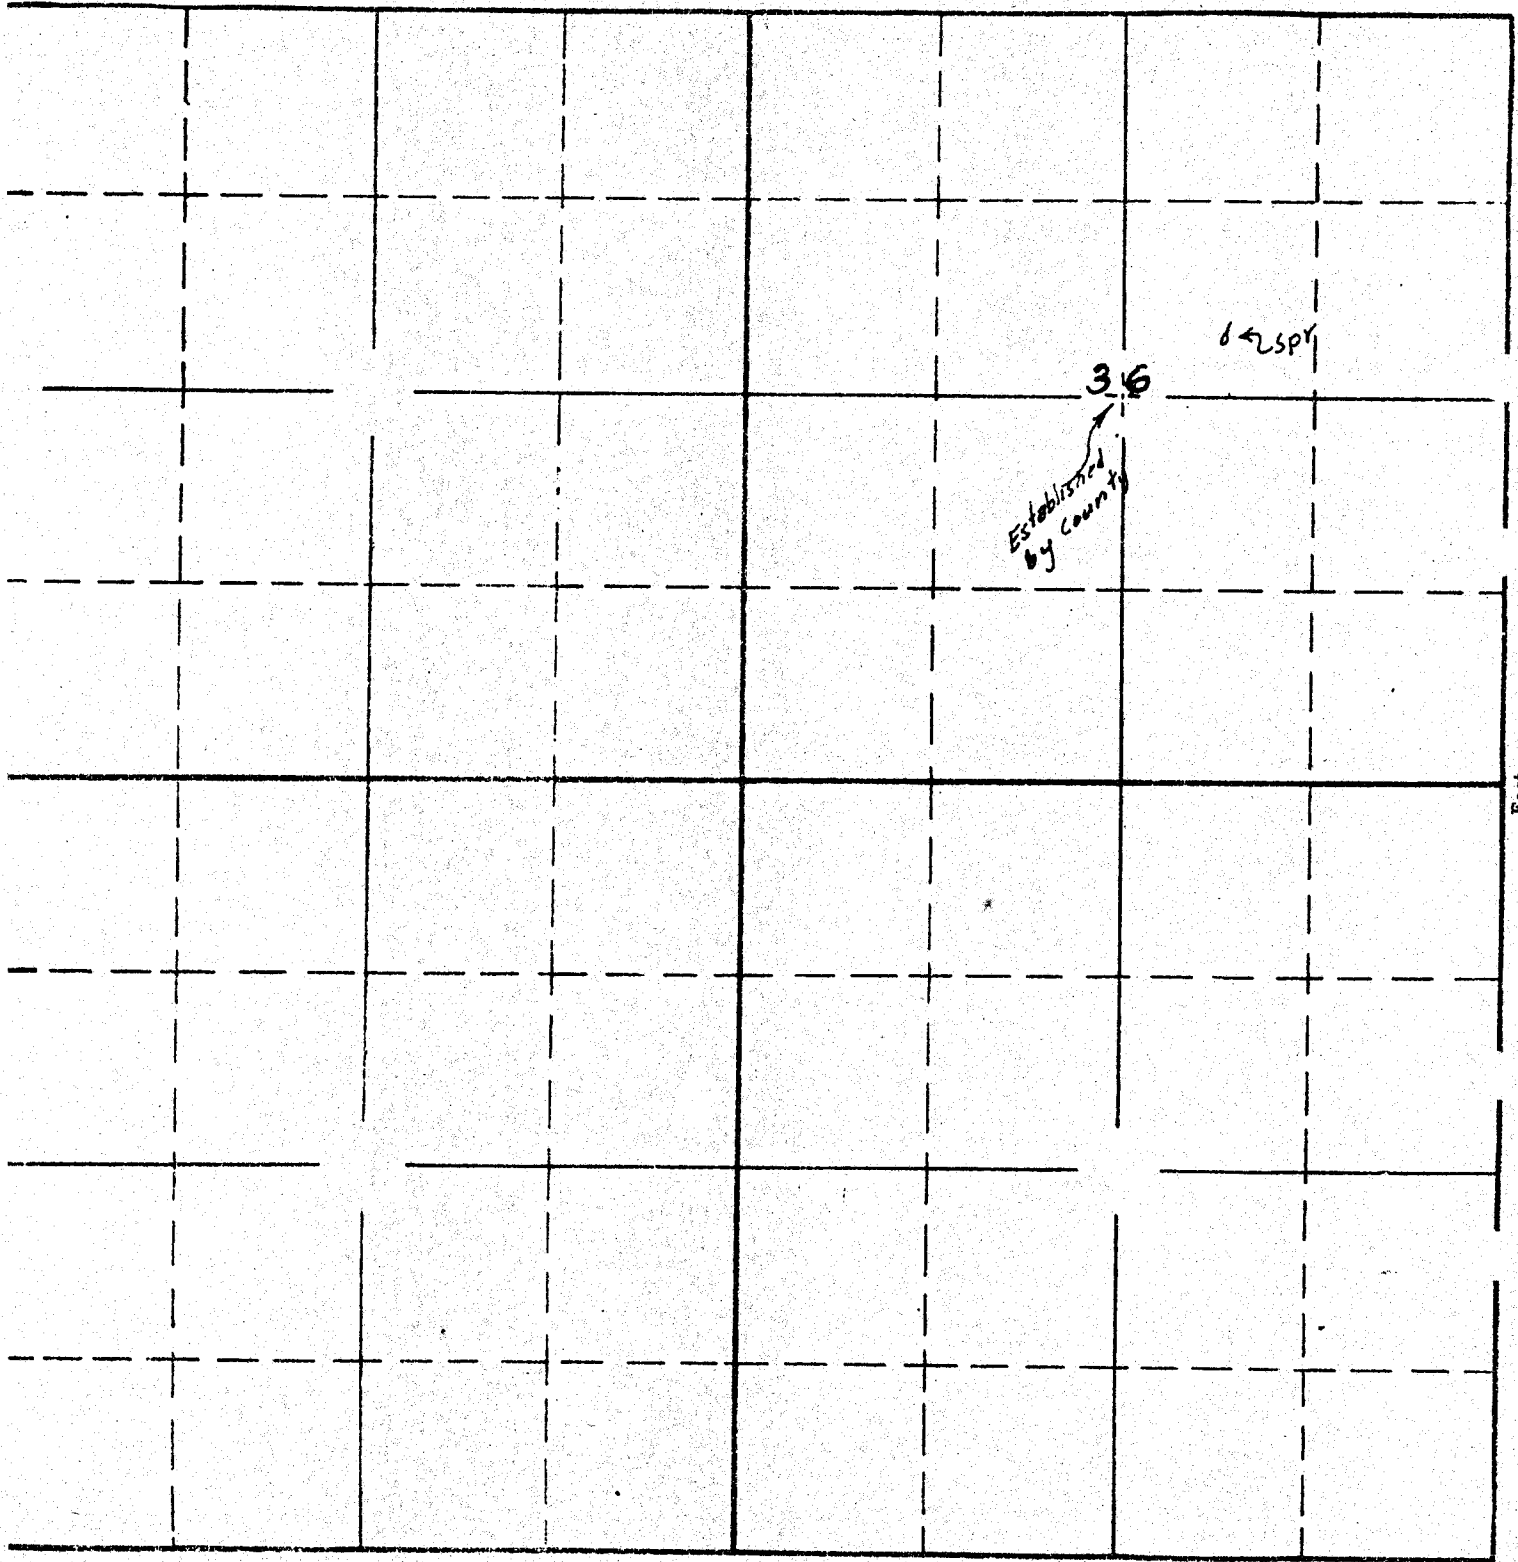

East

South

APPLICATION No. 15410  
PERMIT No. 11339