


MAP

To Accompany Application of Wm Wilkens for a permit to
Appropriate Water in Sec. 17, Twp. 23 S., R. 12 W. W.M., Coos County, ORE.

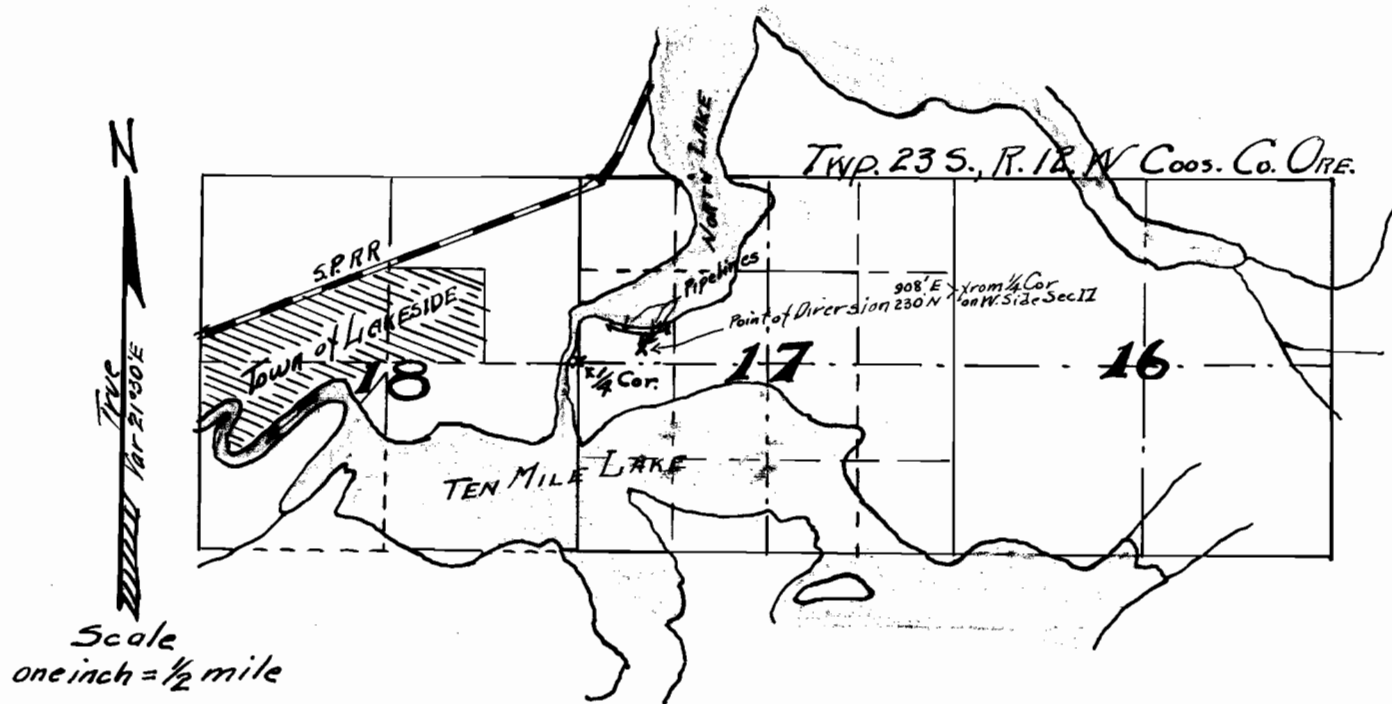

I, D. L. Buckingham, of
MARSHFIELD, OREGON, do hereby
certify that this map was made
from notes taken during an actual
survey made by me Sept. 30, 1934
and that it correctly represents
the works described in the ac-
companying application, together
with the location of the streams
in the immediate vicinity.

D. L. Buckingham



App. No. 15588

Per. No. 11469