


SECTION

TOWNSHIP 26S, RANGE 6W, W. M.

North

32

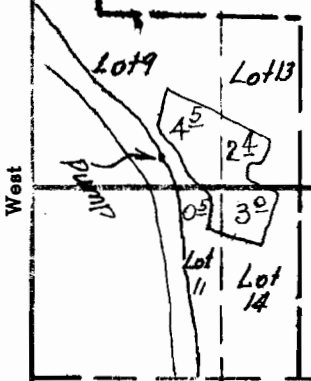

West

East

5

South

*Surveyed by  
C. A. Cummings  
June 10 1939*

APPLICATION No. 15702  
PERMIT No. 11568