


TOWNSHIP 7S, RANGE 31E, W. M.

North

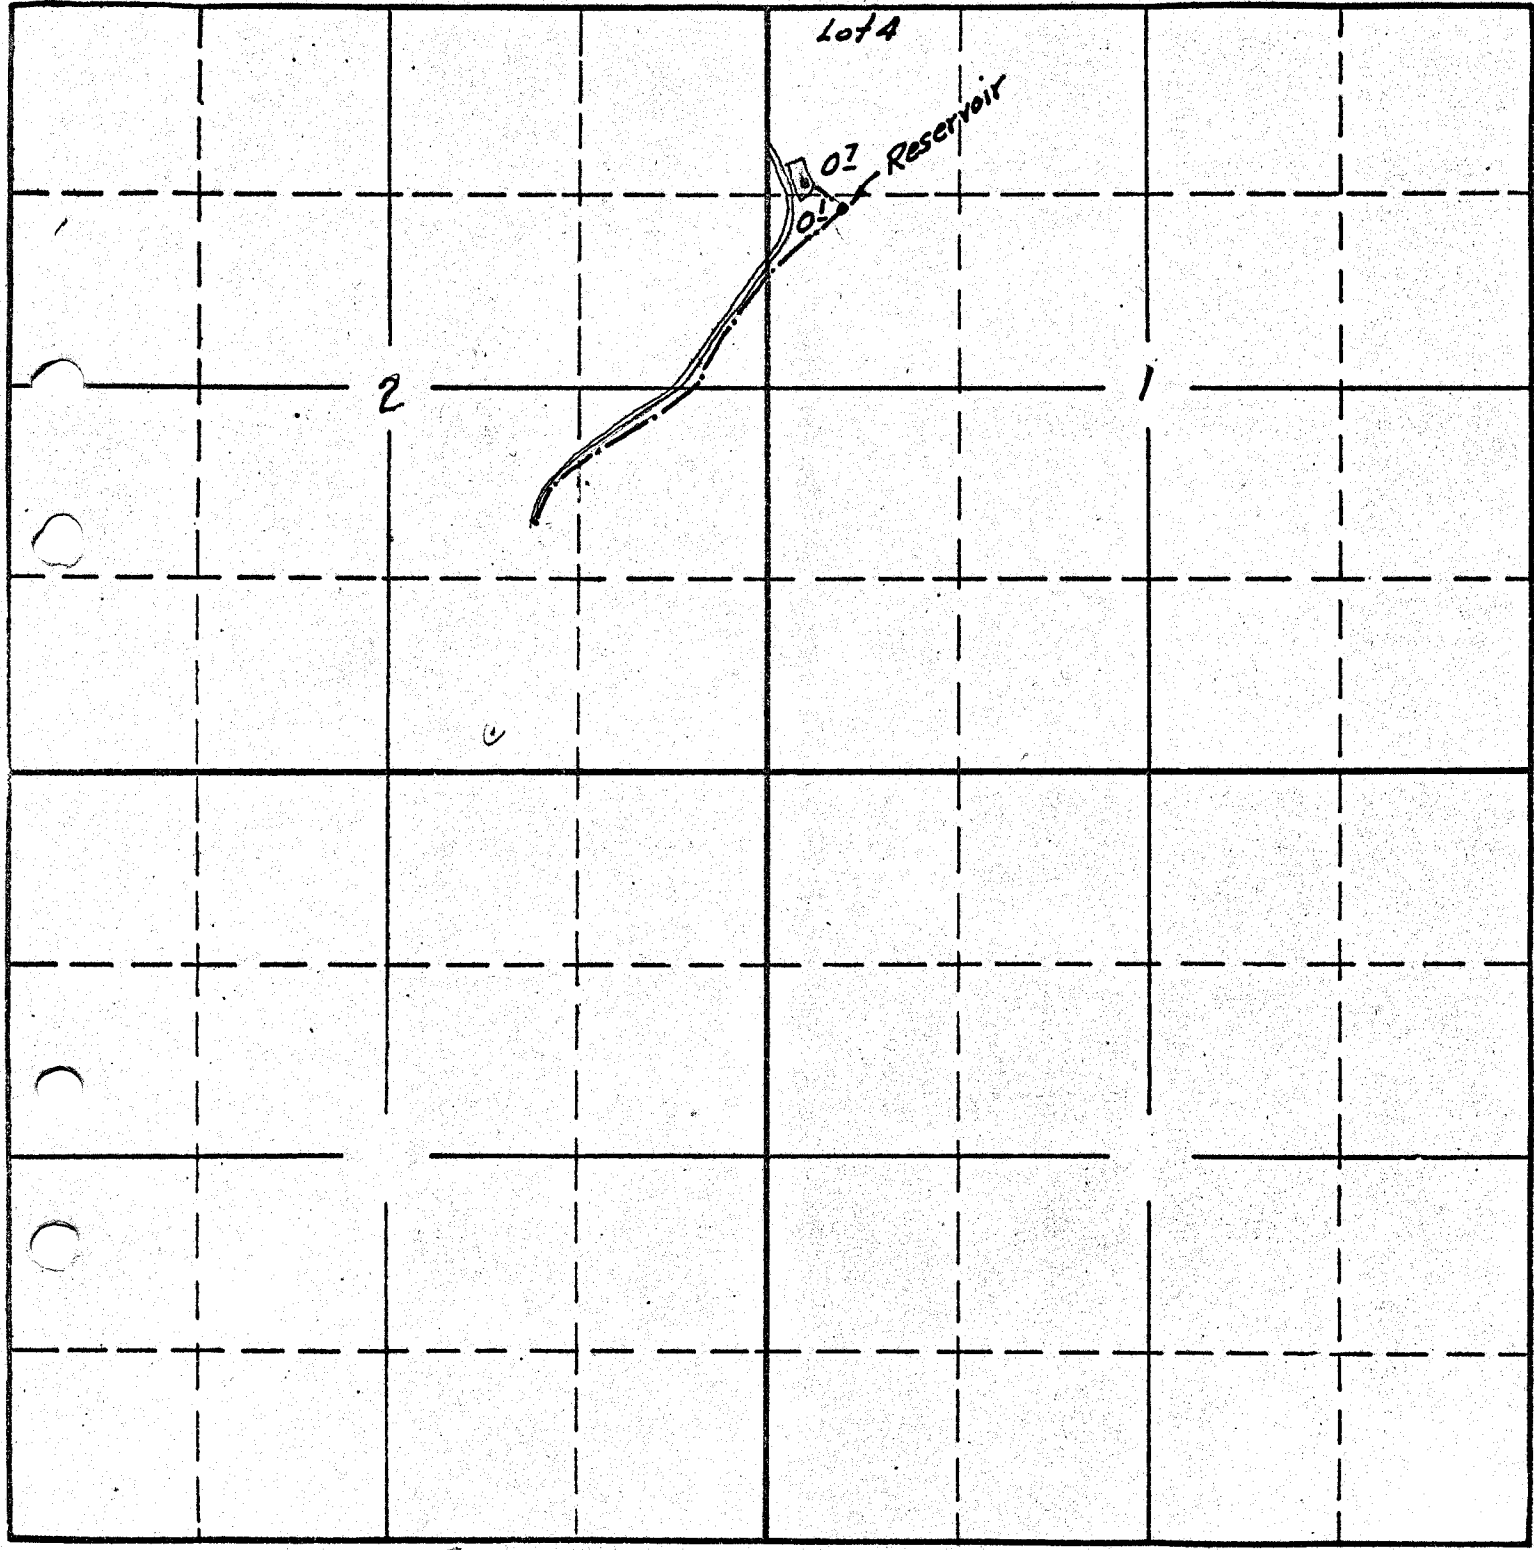

South

Surveyed by CAB  
May 5 1939

16367  
APPLICATION No. 16398  
PERMIT No. 12198  
R690