


Twp 13 S R 24 E

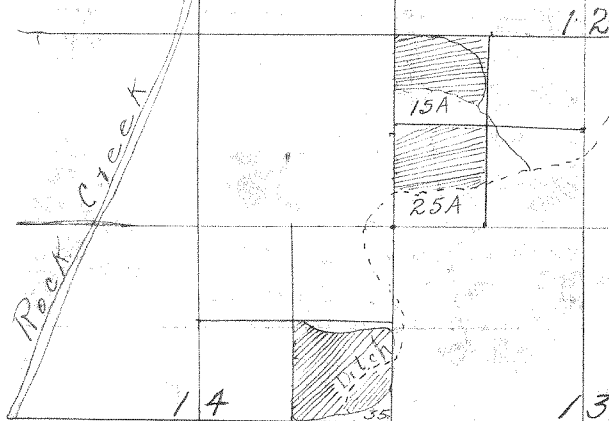

12216

22

23

Rock Creek

DIVERS NOT

27

26

App. No. 16400
Per. No. 12216

4-16400
OK