


SECTION

TOWNSHIP _____, RANGE _____, W. M.

North

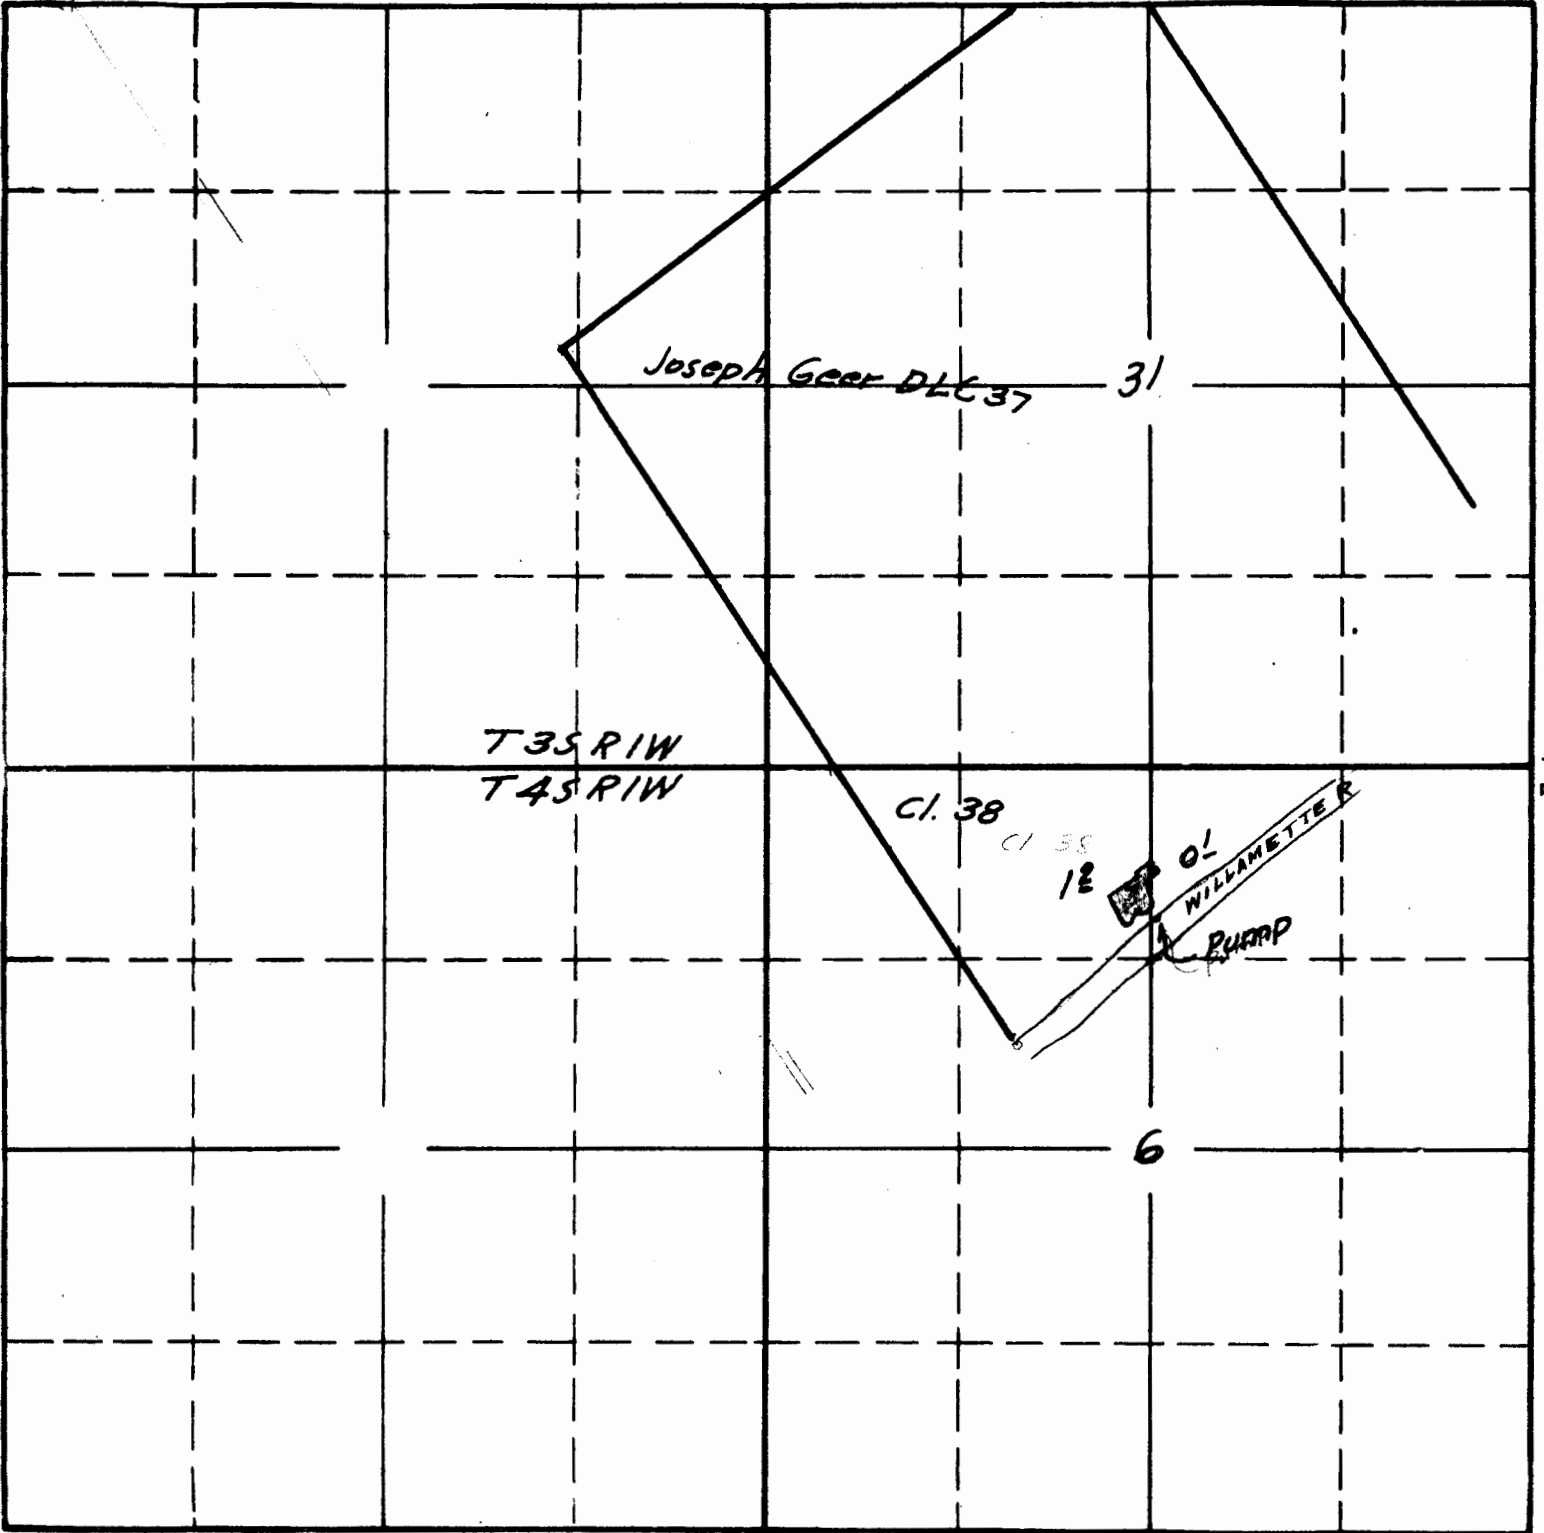

Survey by G. S. May 1 1939

South

APPLICATION No. 16962
PERMIT No. 12718