


SECTION

TOWNSHIP 38 S, RANGE 1 E, W. M.

North

T 38 S, R 1 E W. M.

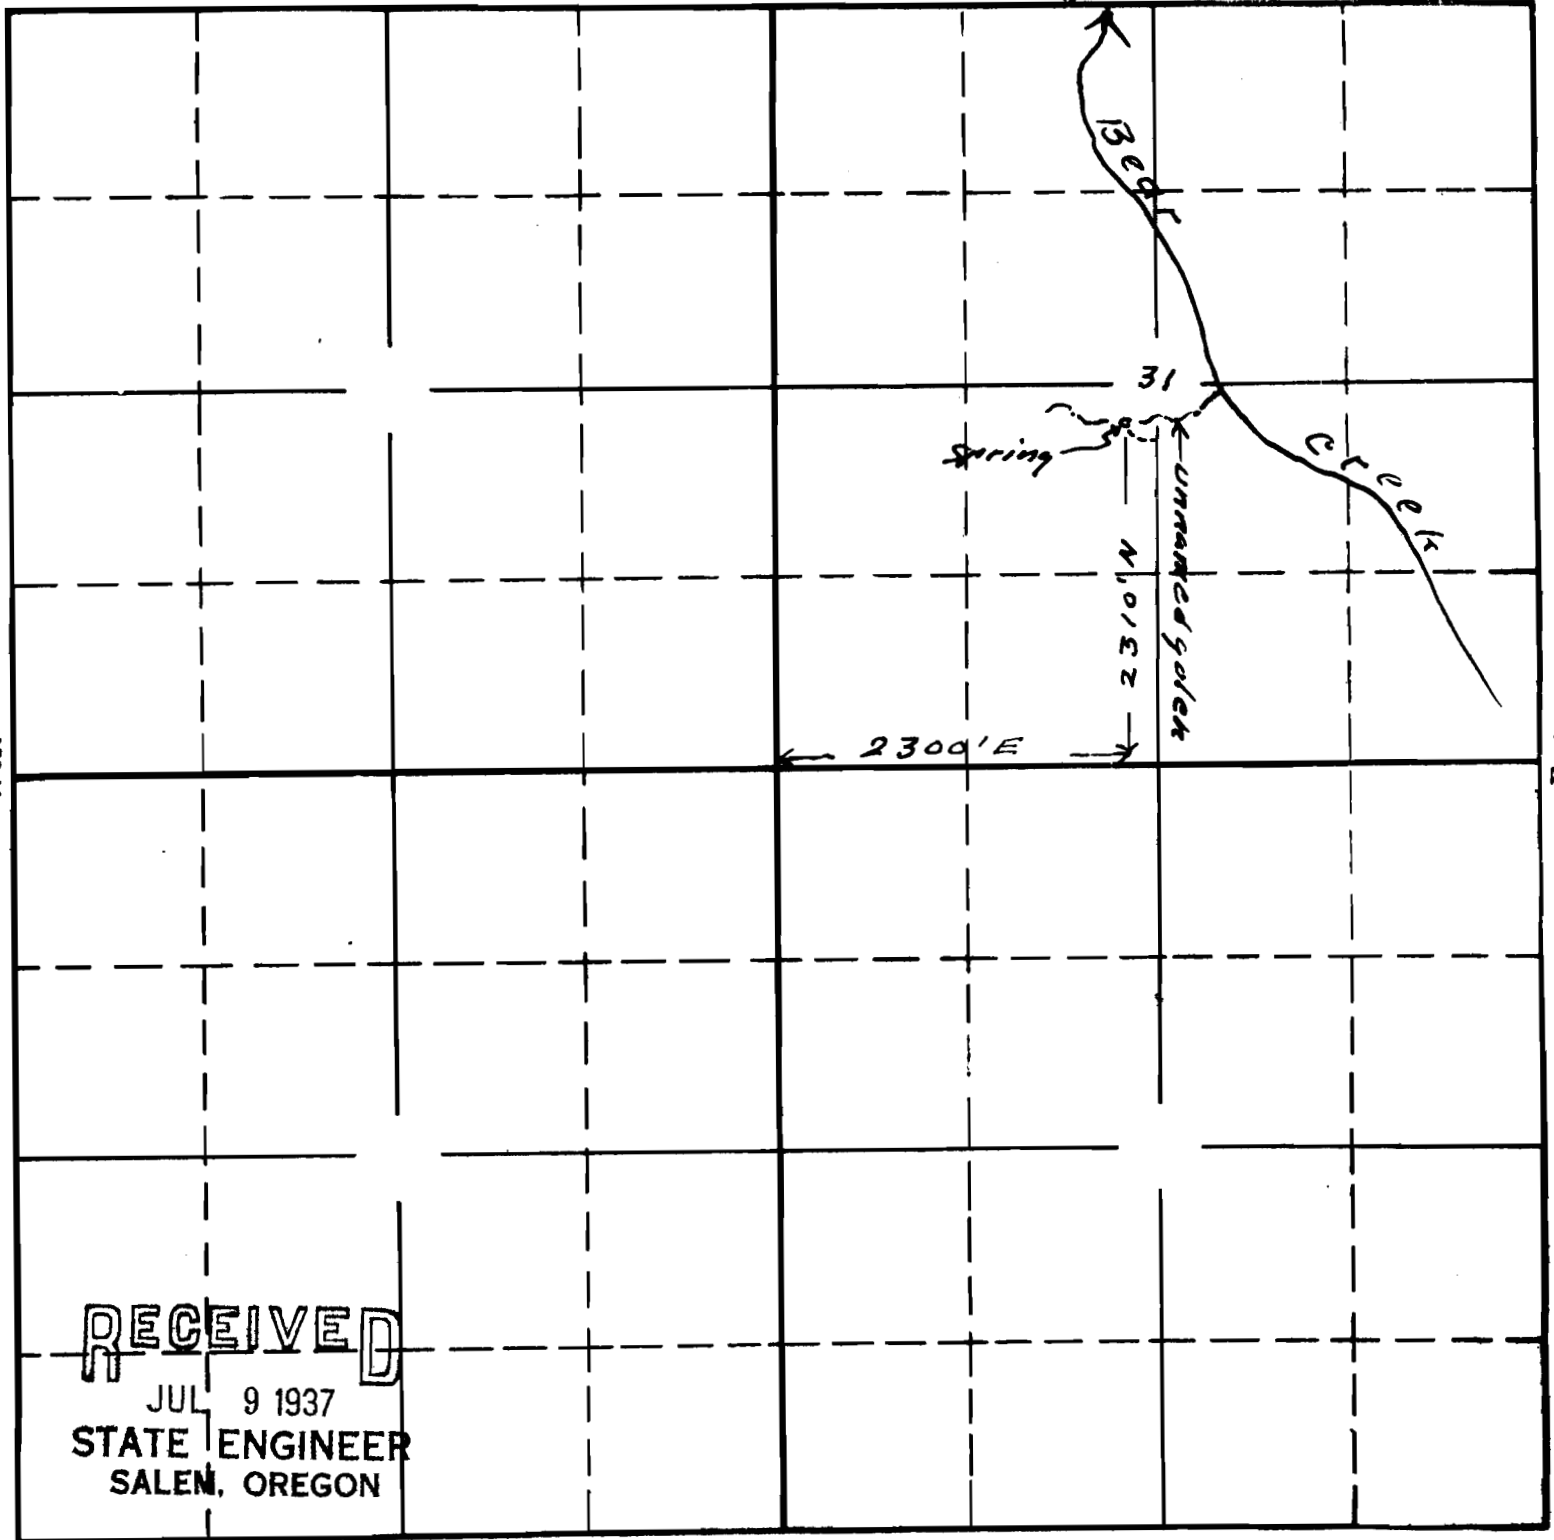

RECEIVED

JUL 9 1937
STATE ENGINEER
SALEM, OREGON

South

Sketch to accompany application of
Ralph and Homer Billings for the
use of spring developed in mining tunnel
and waters of unnamed gulch

16971 OK
APPLICATION No. 16971
PERMIT No. 12725