


SECTION

TOWNSHIP 4S, RANGE 5W, W. M.

North

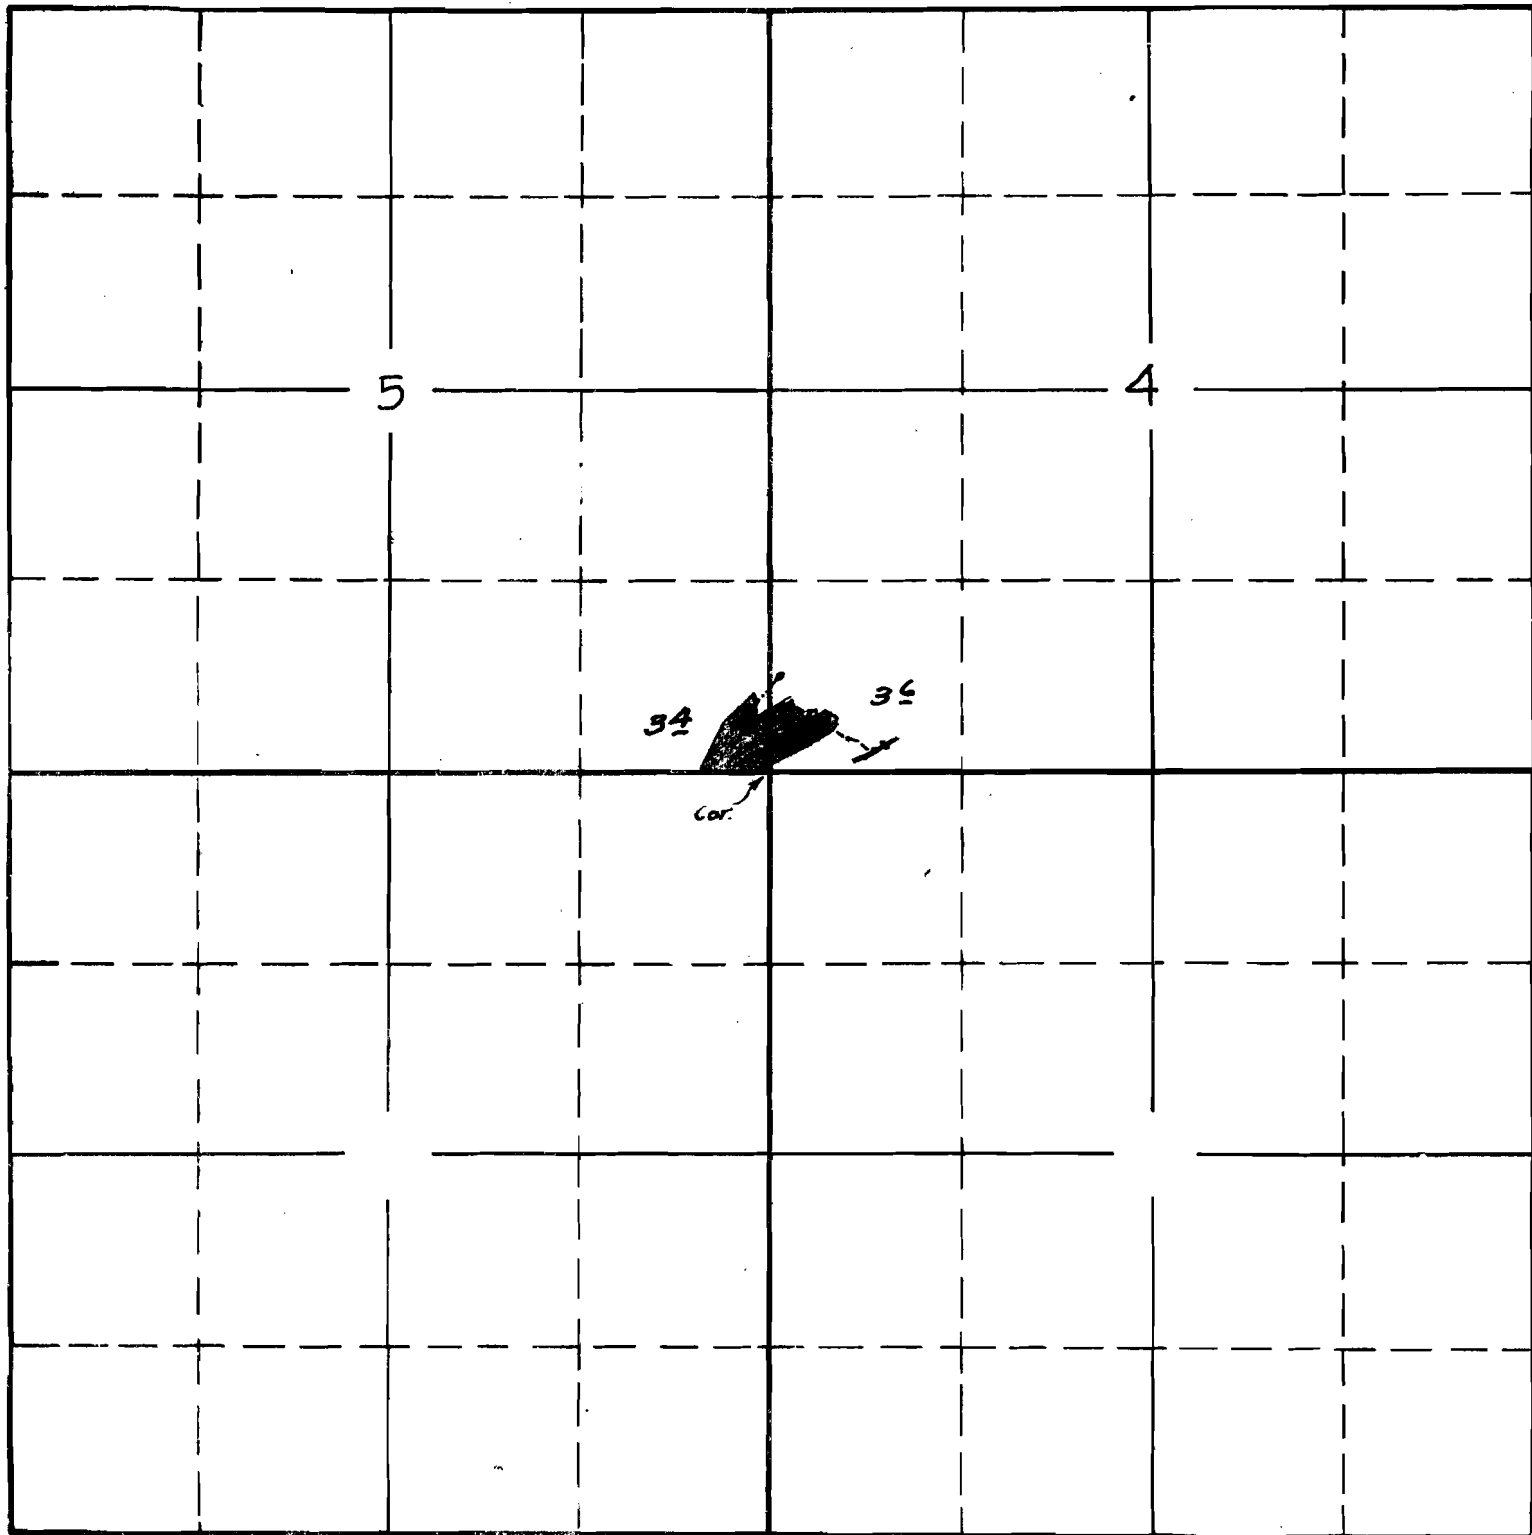

South

APPLICATION No. 16982
PERMIT No. 12732

SECTION


4

5

9

TOWNSHIP 4S, RANGE 5W., W. M.

North

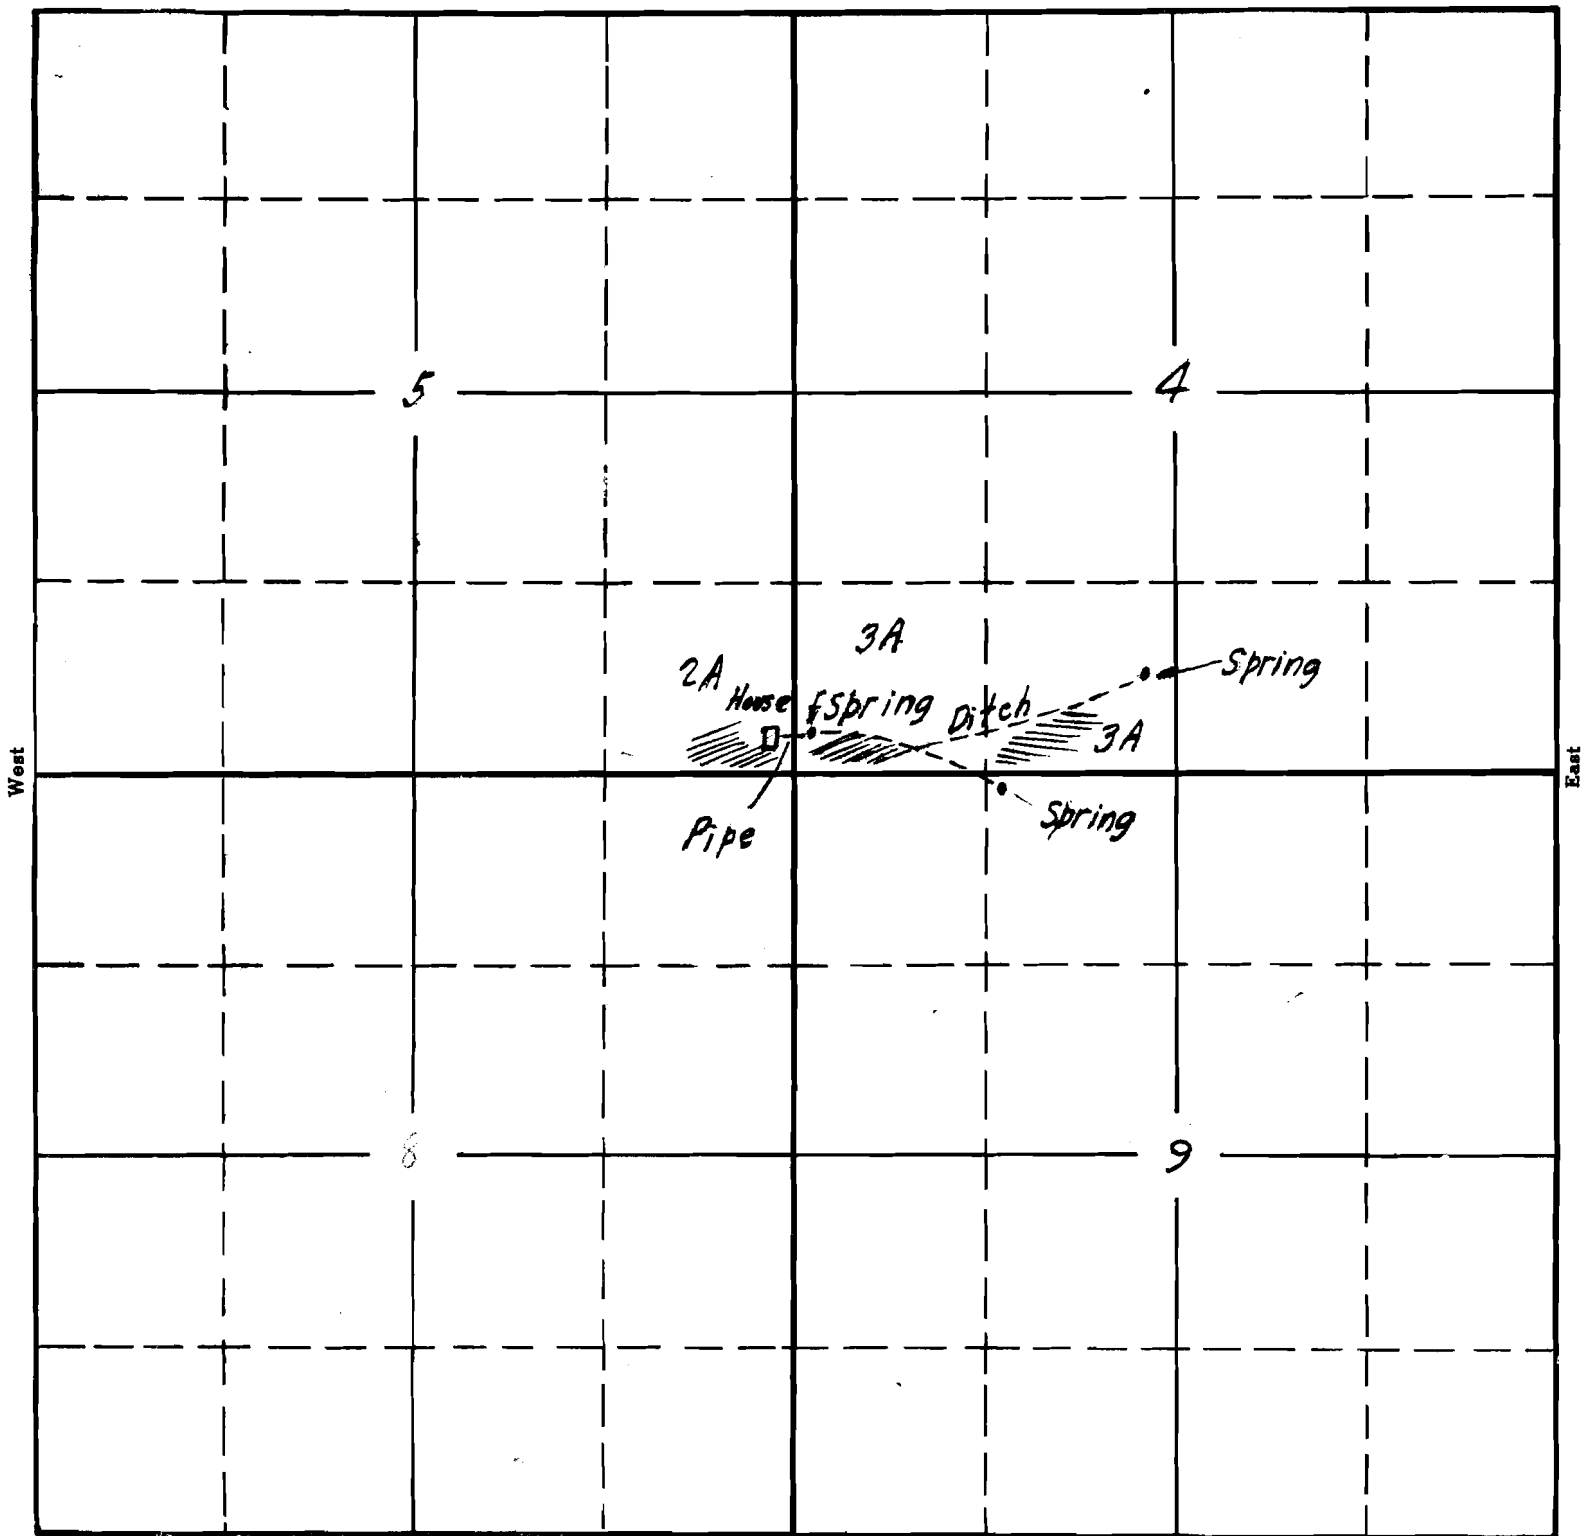

South

APPLICATION No. 16982
PERMIT No. 12732