


SECTION

\_\_\_\_\_  
\_\_\_\_\_  
\_\_\_\_\_

TOWNSHIP 4S, RANGE 3E, W. M.

North

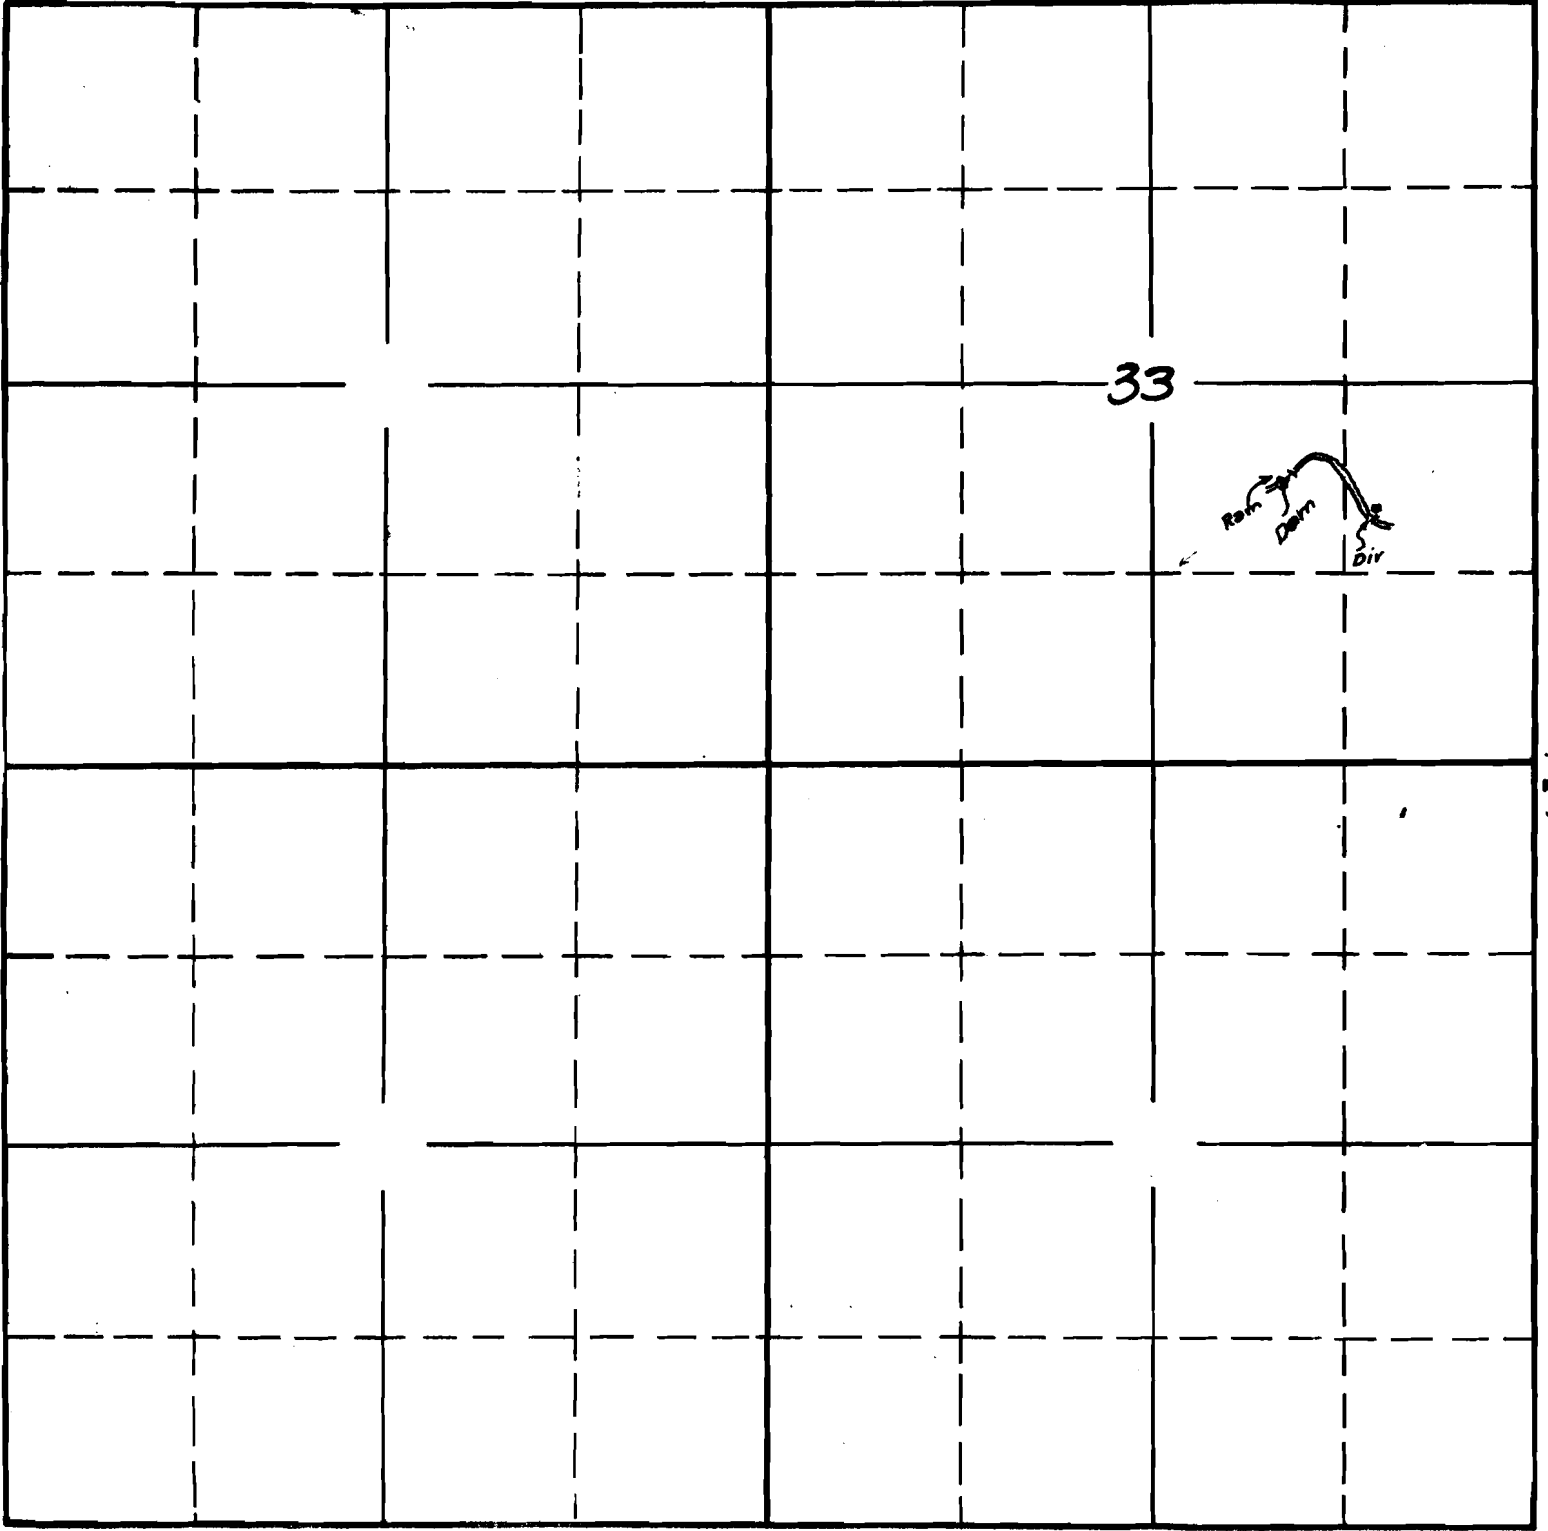

South

Surveyed by  
C. A. Cummings  
Apr 10 1939

APPLICATION No. 17328

PERMIT No. 13042