


SECTION

TOWNSHIP _____, RANGE 7 S, W. M.

North

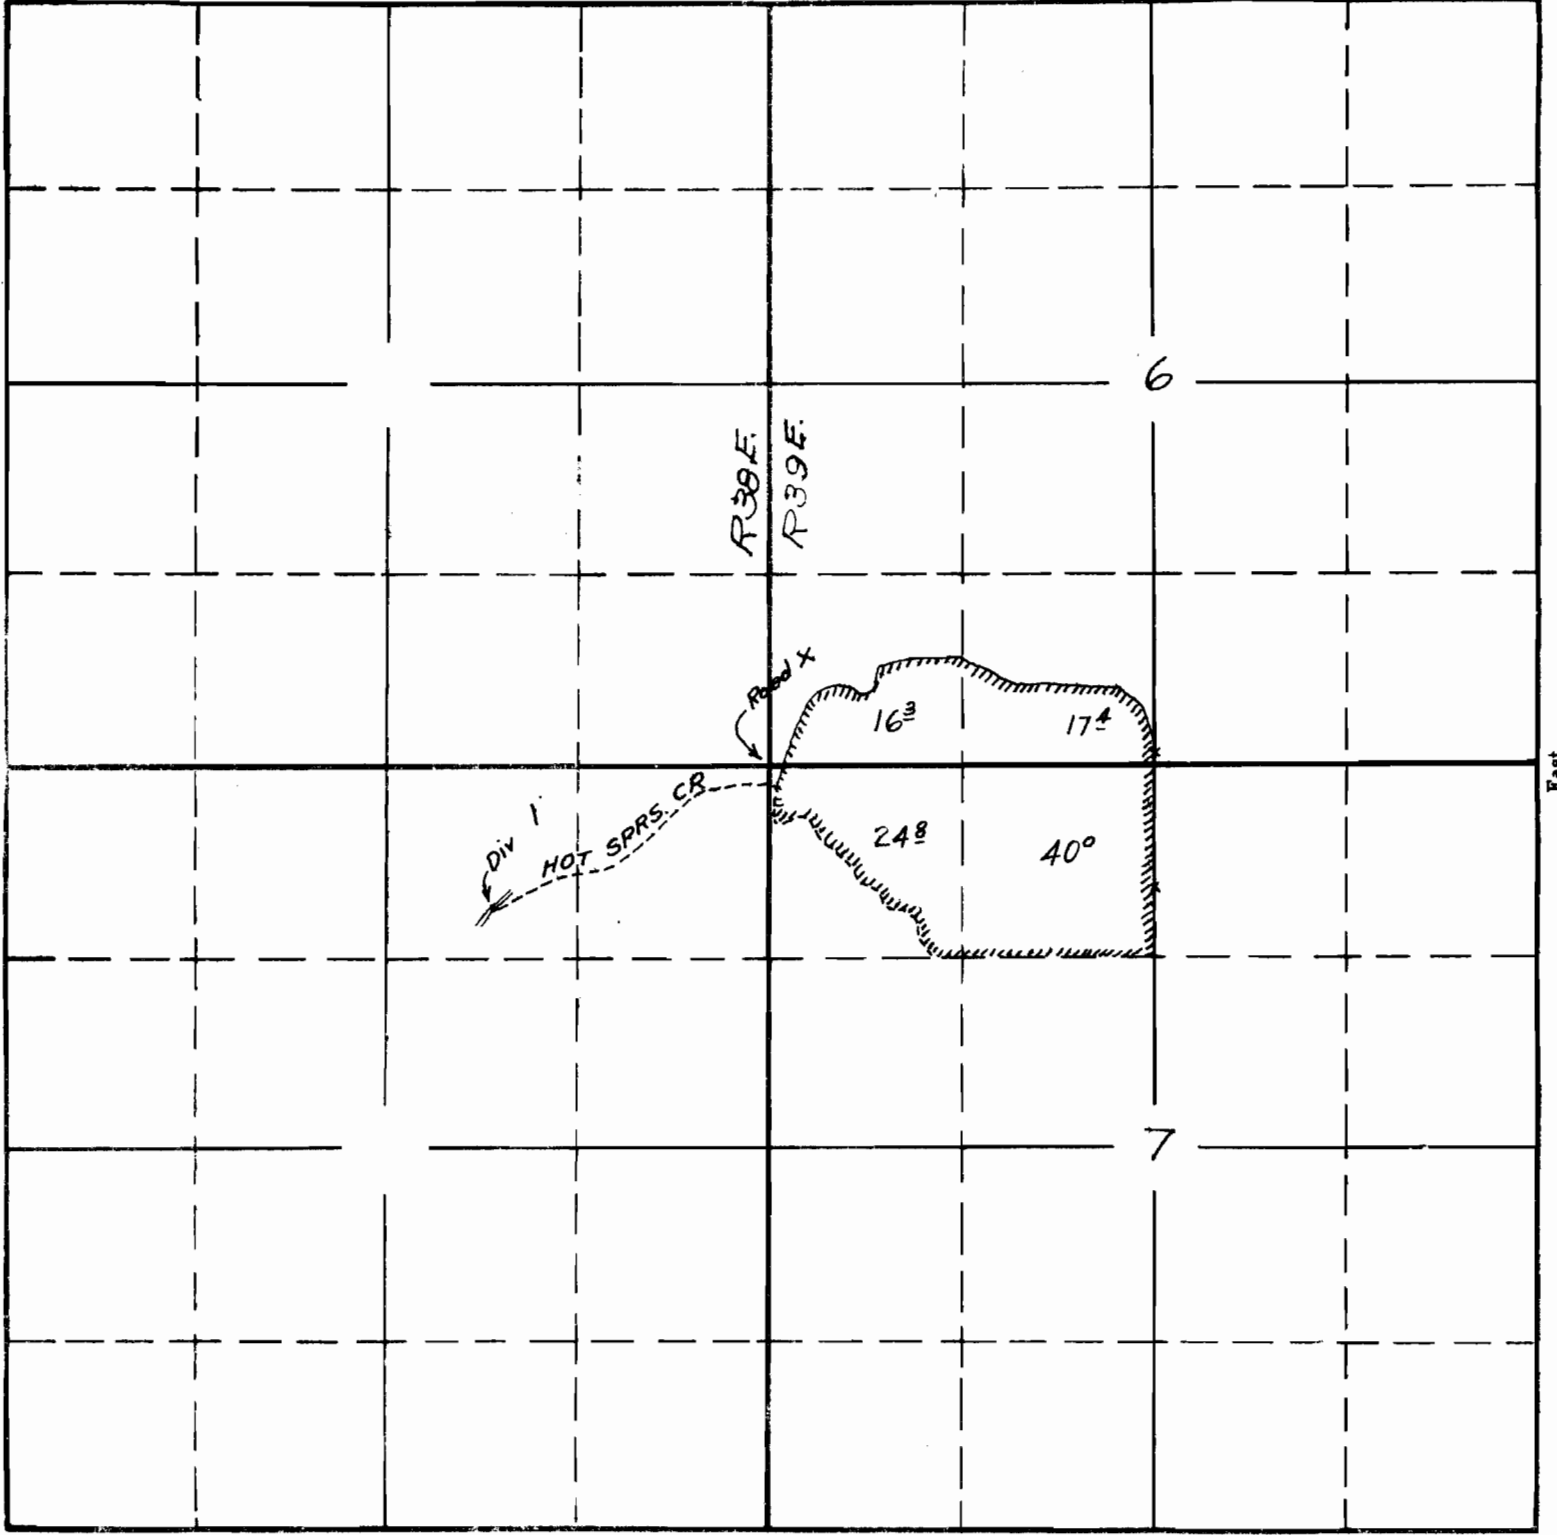

APPLICATION No. 17358

PERMIT No. 13066