


SECTION

TOWNSHIP 2 S., RANGE 2 E., W. M.

North

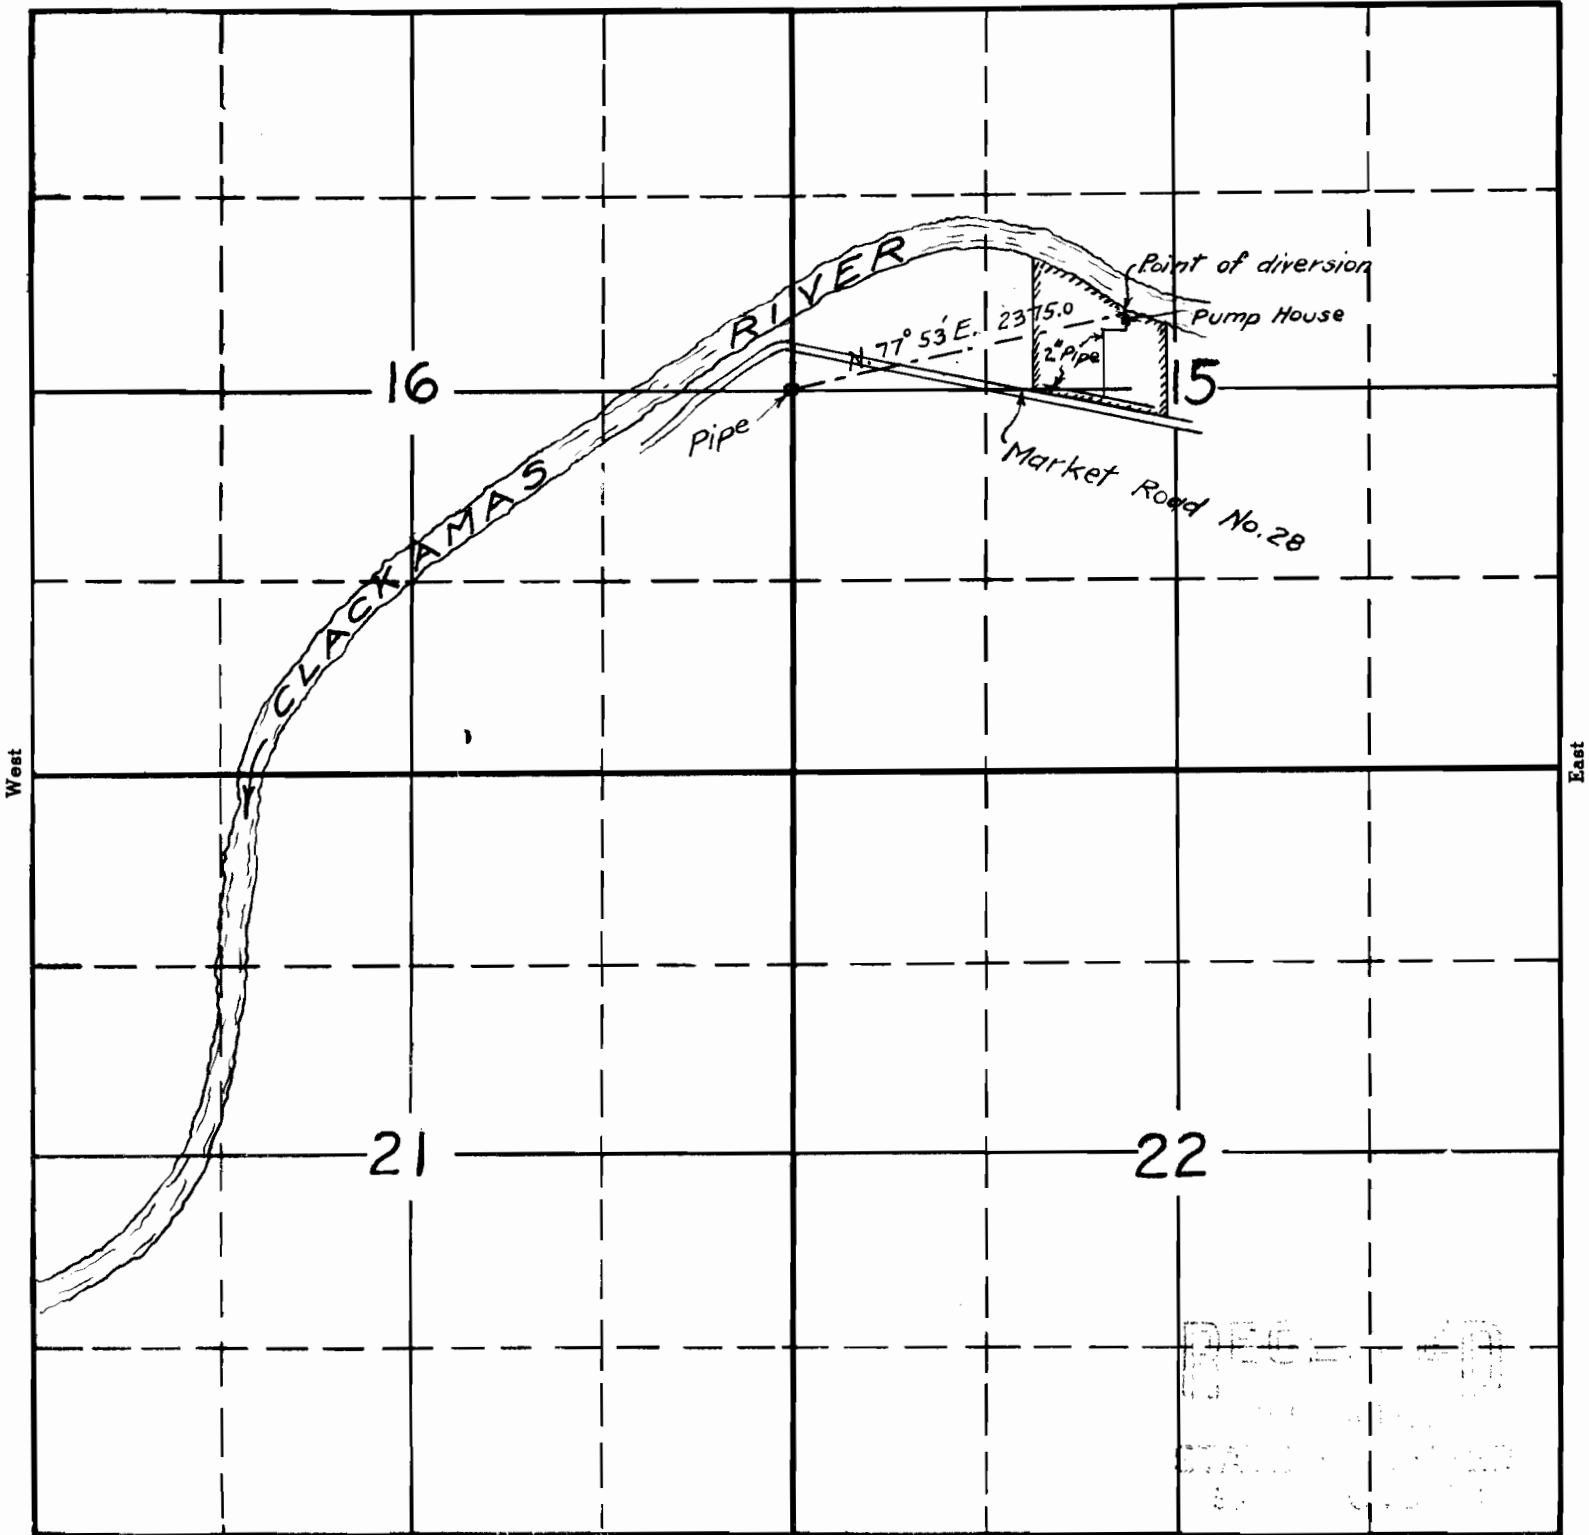

West

East

South

REC-40
STANDARD
5-1-38

17534

O. Stoehr

I, O. Stoehr of Portland, Ore, do hereby certify that this map was made from notes taken during an actual survey made by me on Aug. 10, 1938, and that it correctly represents the works described in the accompanying application

O. Stoehr

APPLICATION No. 17534
PERMIT No. 13239