


13 & 14

TOWNSHIP 23 S, RANGE 1 E, W. M.

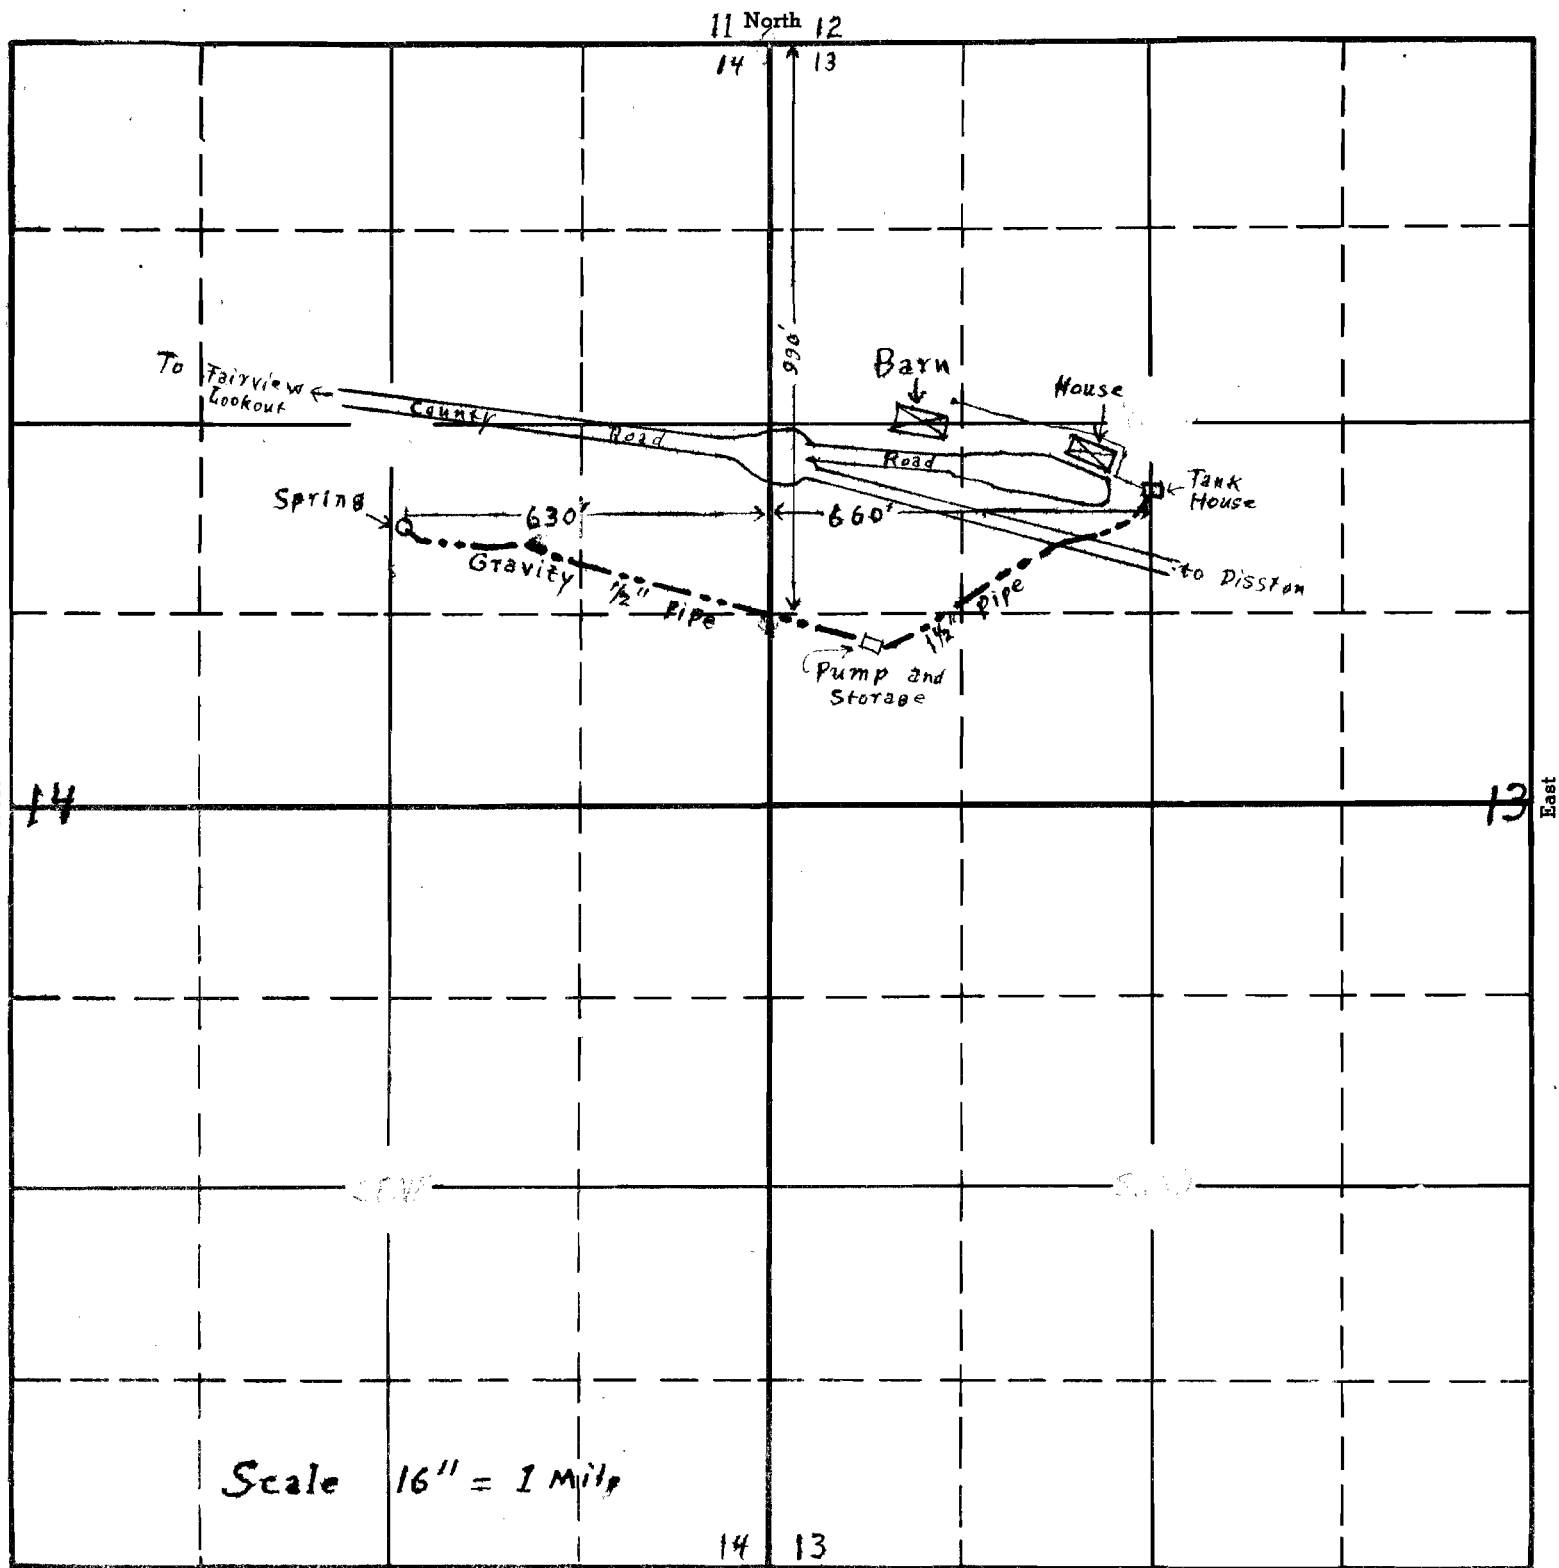

Scale 16" = 1 Mile

14 13

South
1/4
COTTON

17713 OK
16-28


APPLICATION No. 17713

PERMIT No. 13407

SECTION

TOWNSHIP 23S, RANGE 1E, W. M.

North

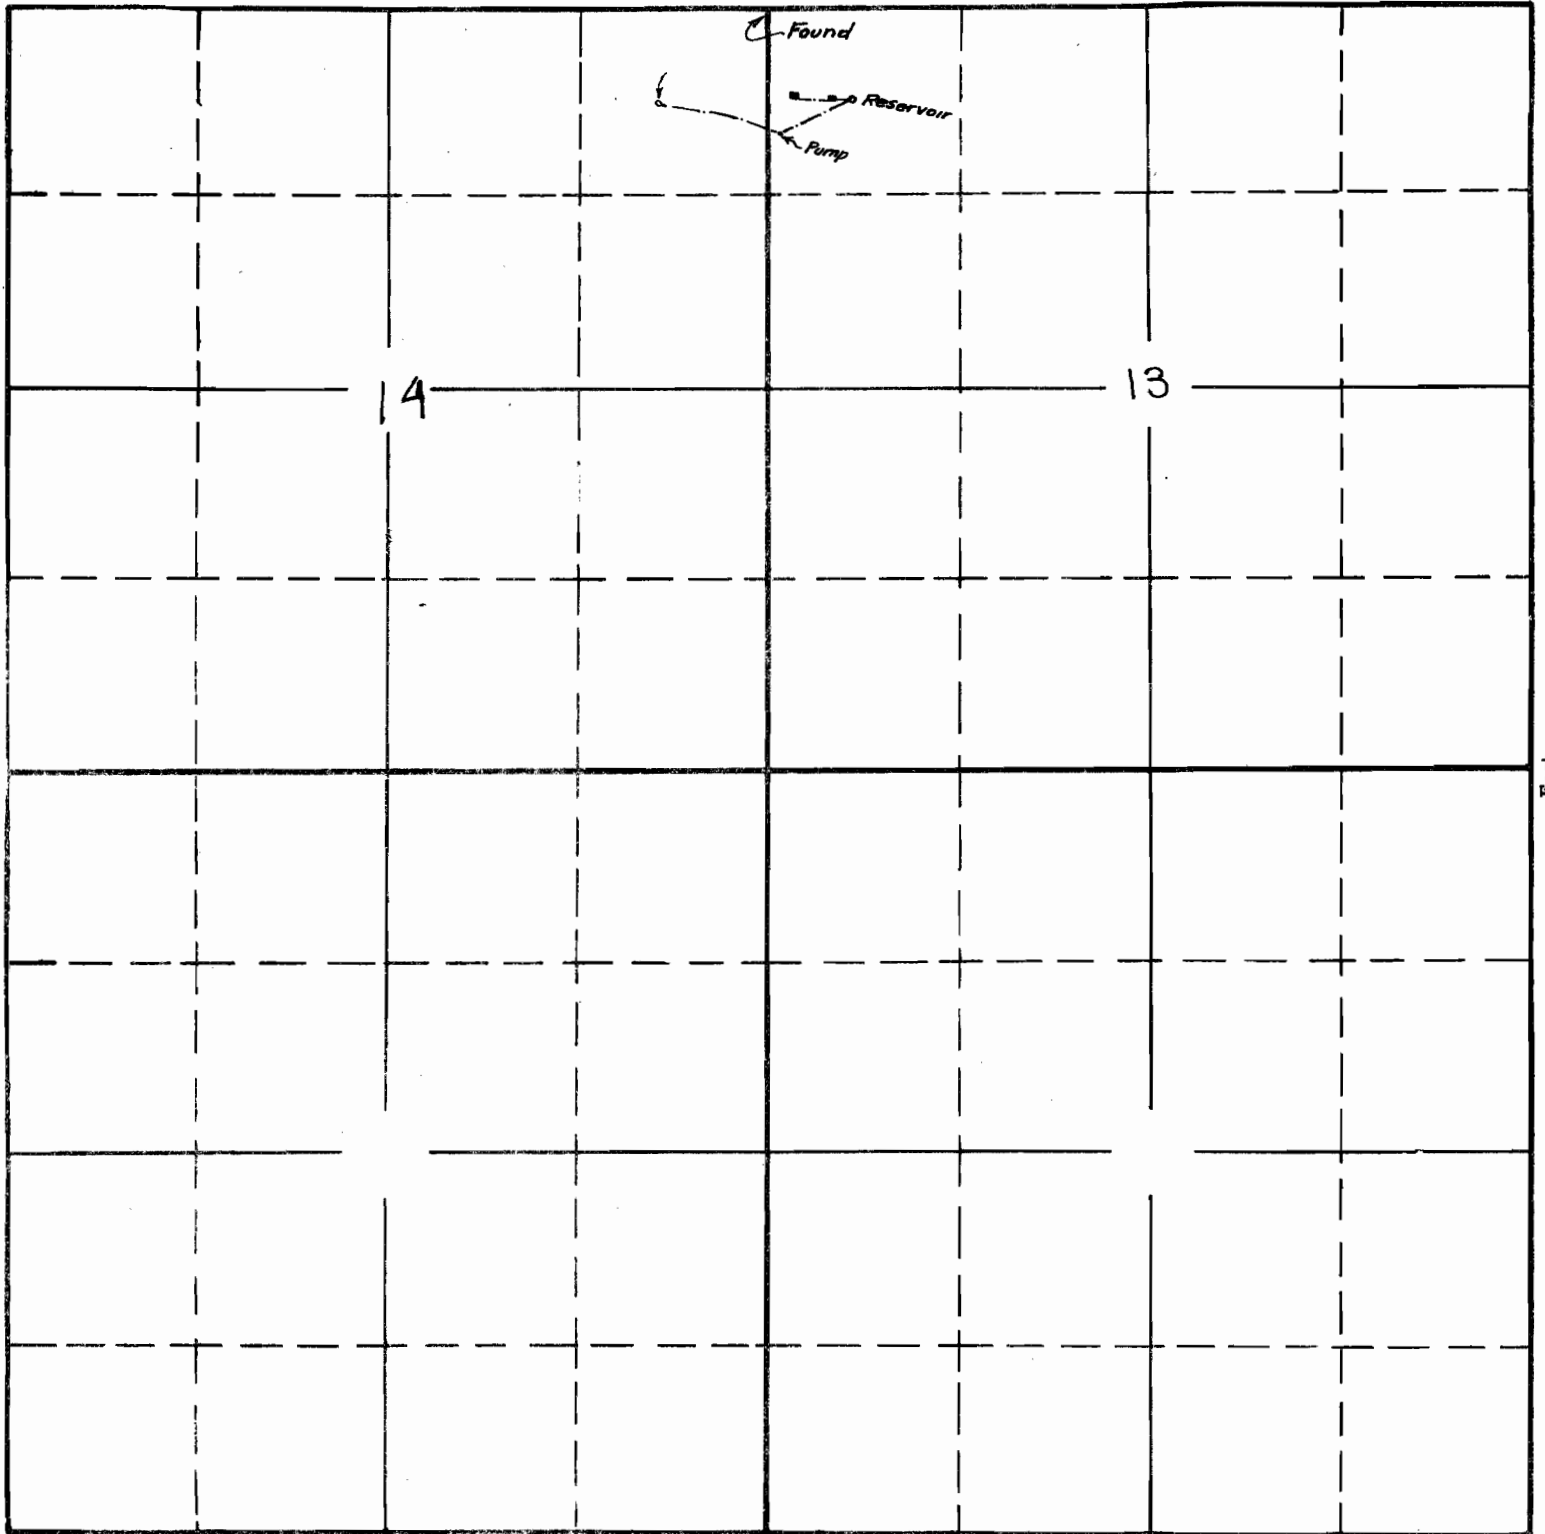

Surveyed by
C. A. Cummings
June 8 1939

South

APPLICATION No. 17713
PERMIT No. 13407