


SECTION
~~2082917 & 20~~
UNSERVEYED

Silent Creek

TOWNSHIP 28 S, RANGE 6 E, W. M.

North

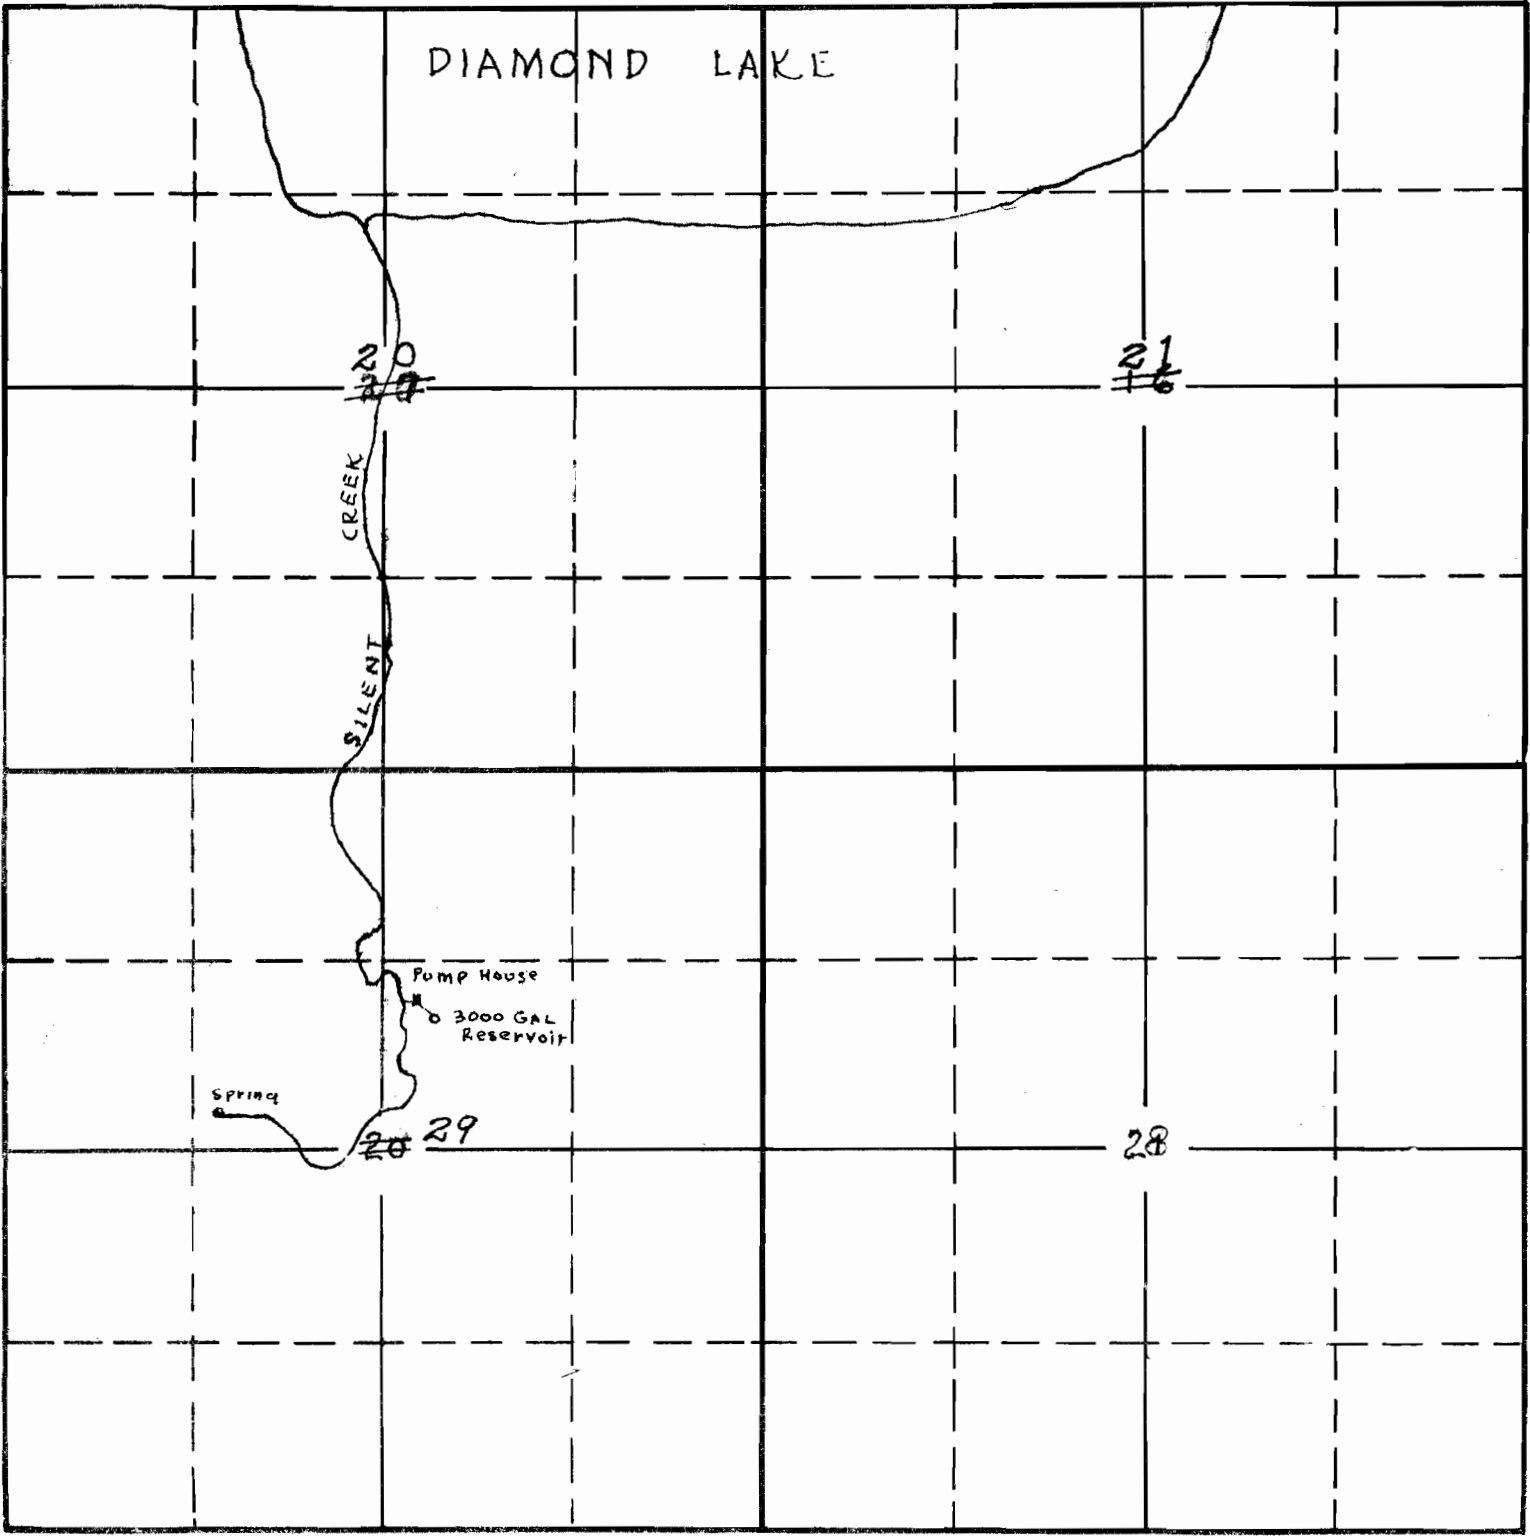

South

7716
16-28
APPLICATION No. 17716
PERMIT No. 13420