


SECTION

TOWNSHIP _____, RANGE _____, W. M.

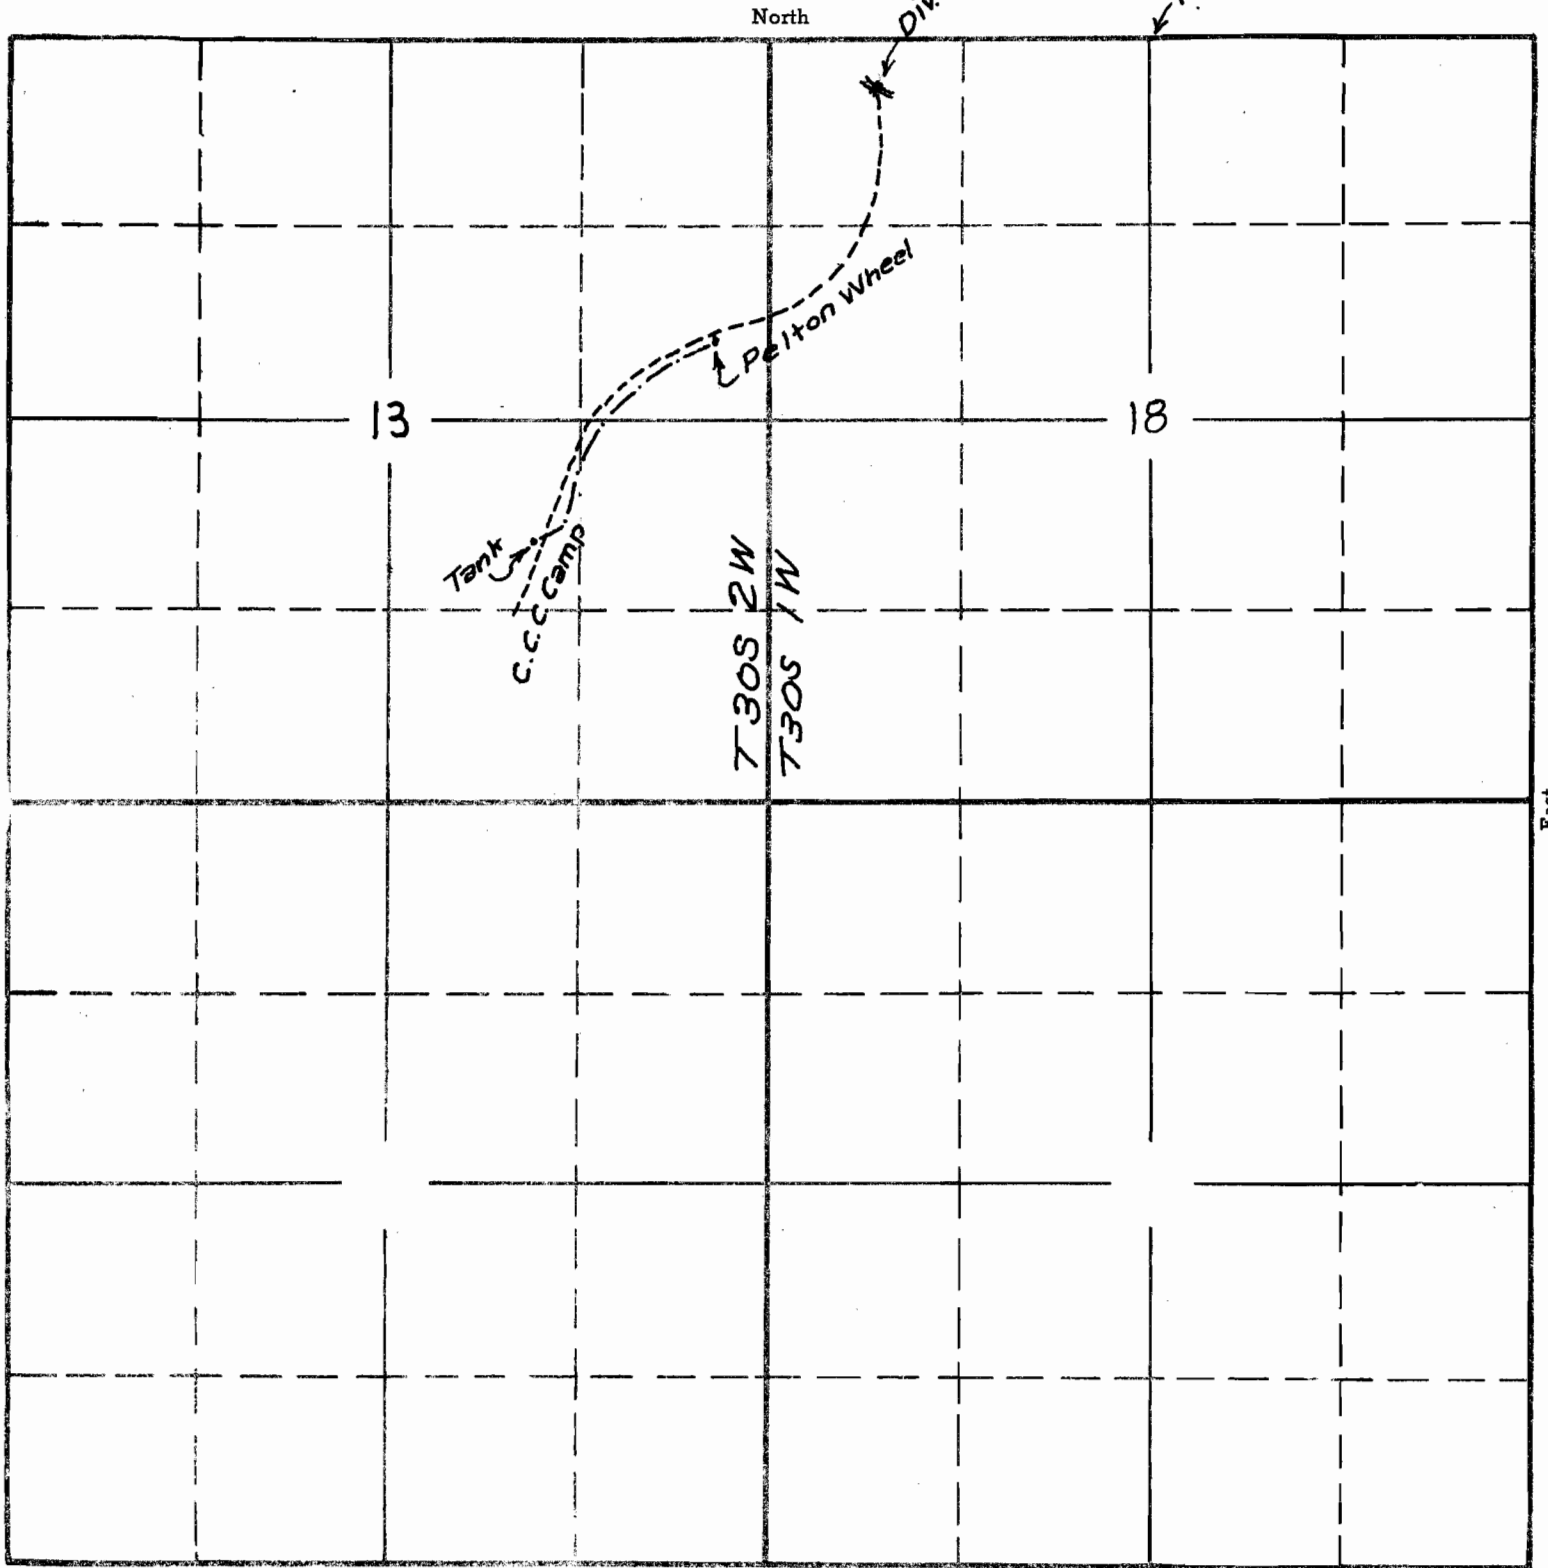

Surveyed by
C. A Cummings
June 12 1939

APPLICATION No. 17717
PERMIT No. 13421