


~~13426~~

13426

TOWNSHIP 2 N, RANGE 8 E, W. M.

North

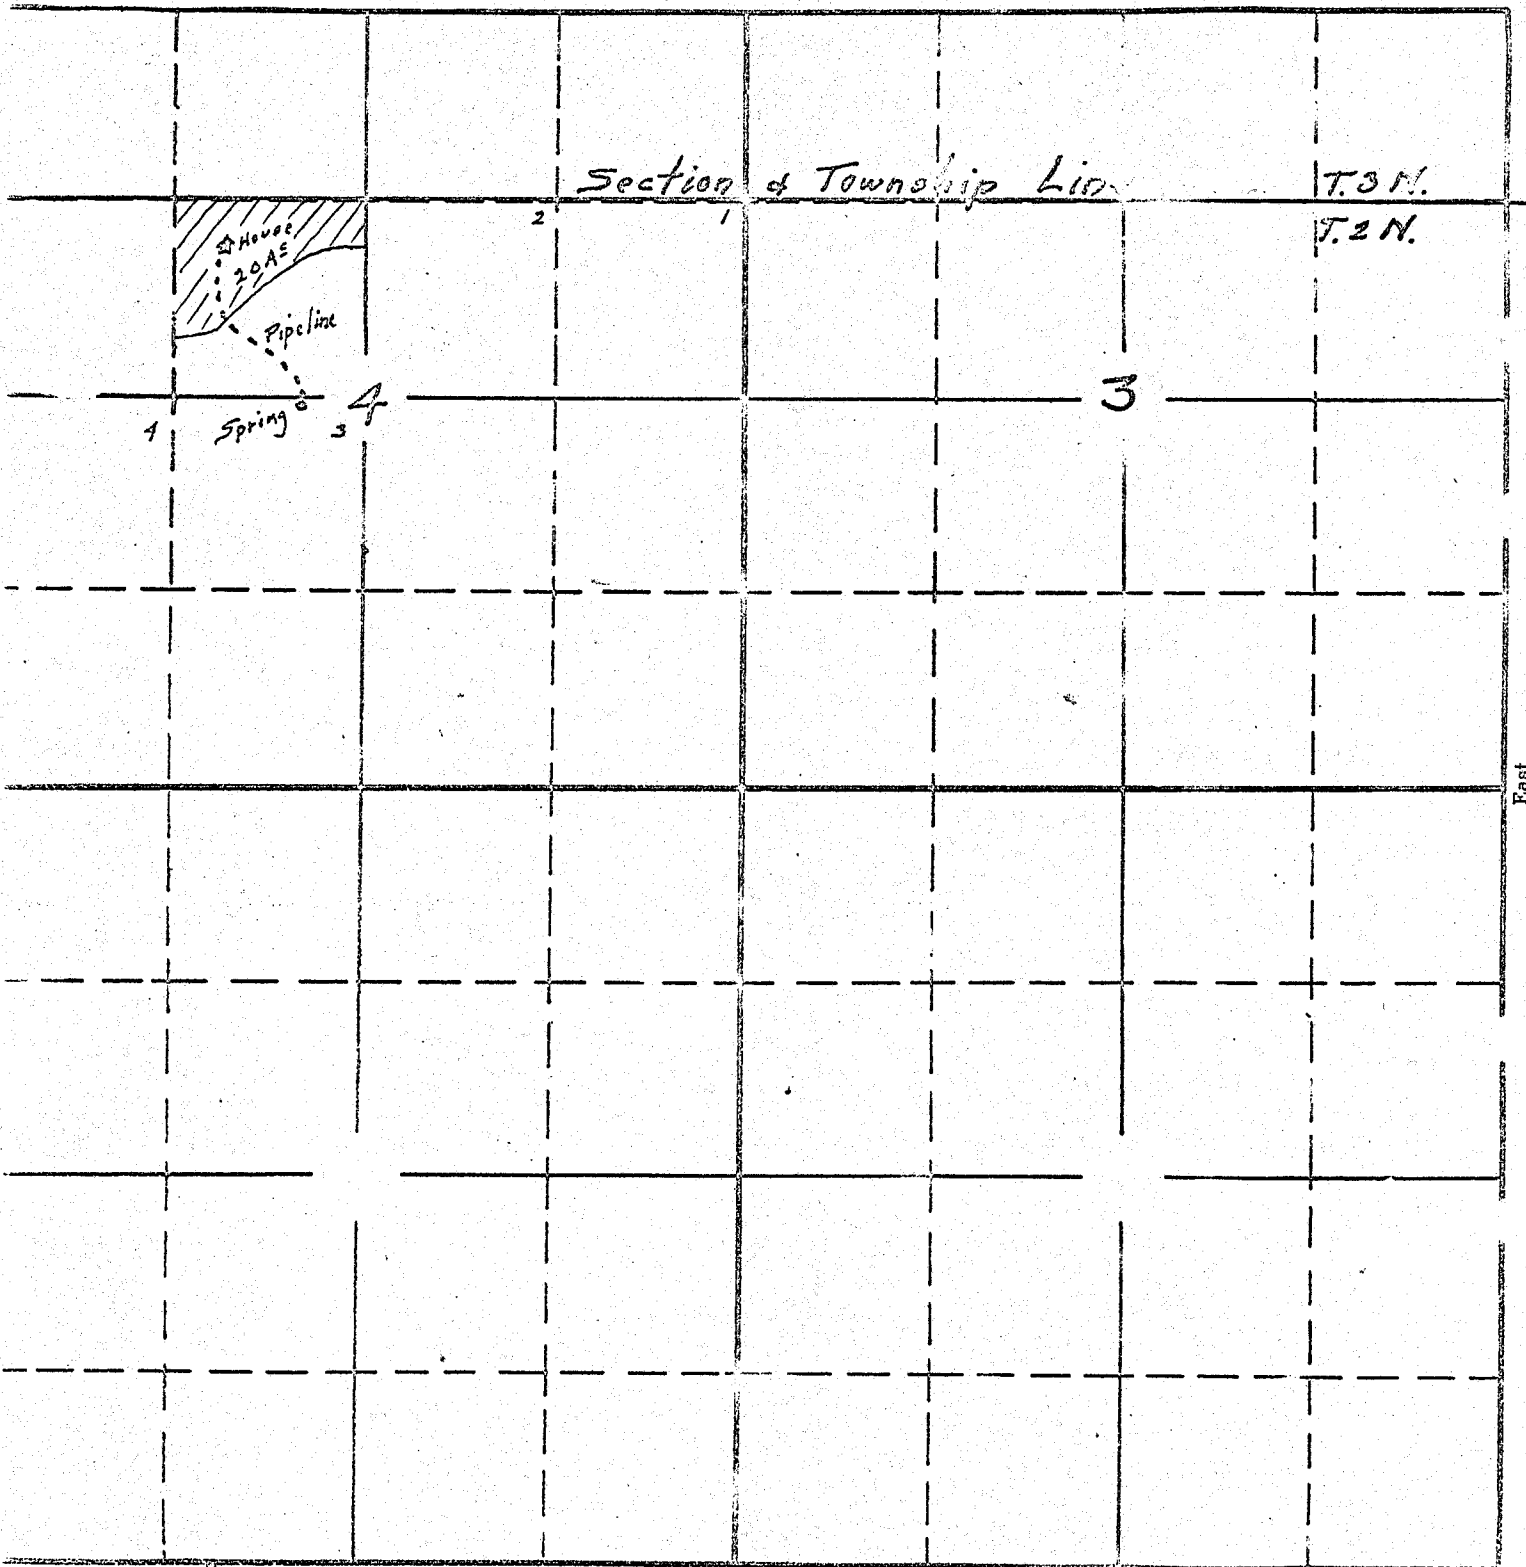

East

South

Copied from applicant's sketch - 4/30/37

4-5-16853 - OK

APPLICATION No. 16853

PERMIT No. ~~4-5-16853~~

~~4-5-16853~~

13426