


SECTION

32
33

TOWNSHIP 4 N, RANGE 38 E, W. M.

North

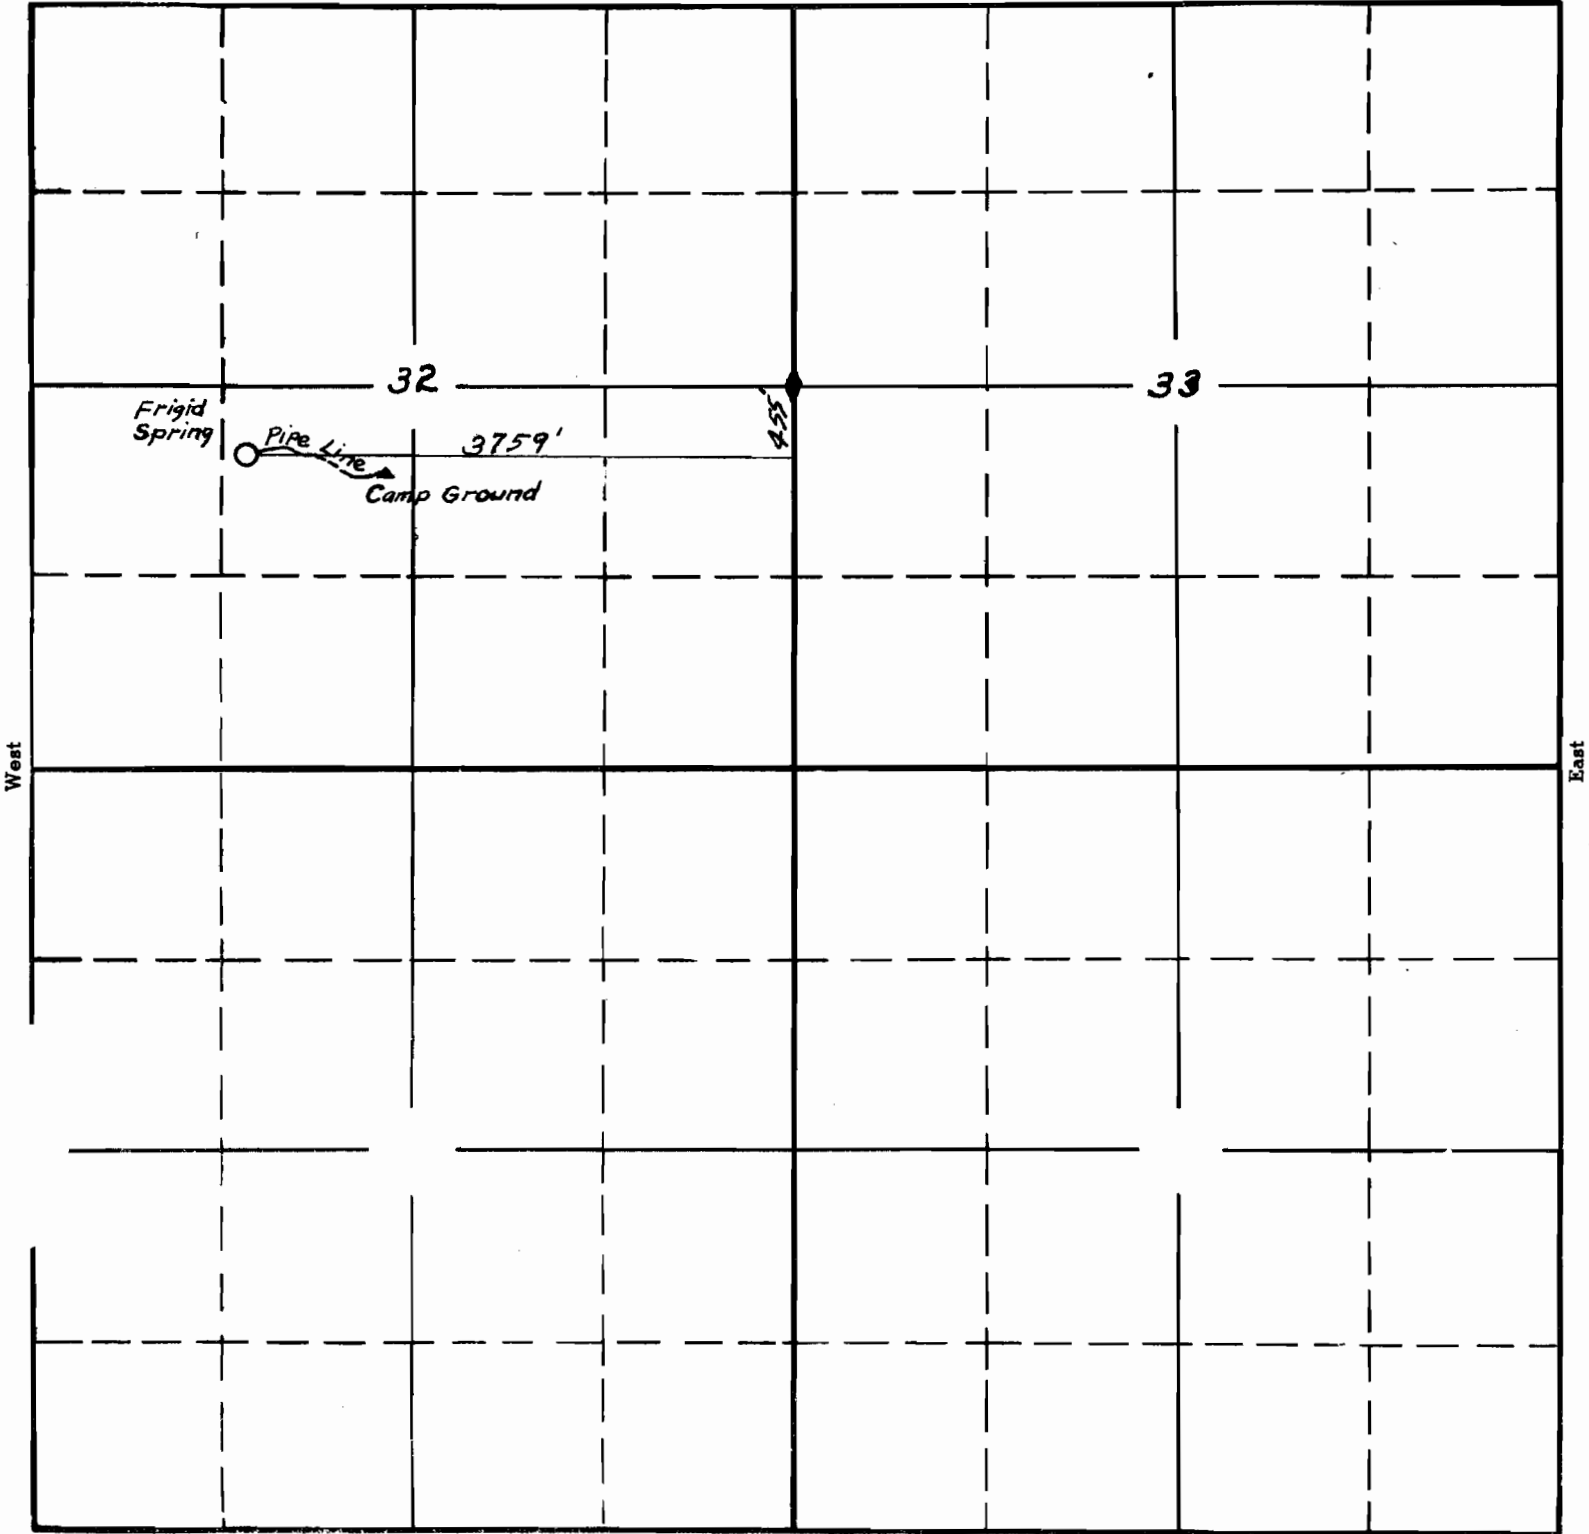

Scale 4" = 1 mile

South

18205 a
5-18

APPLICATION No. 18205
PERMIT No. 13829