


SECTION

TOWNSHIP 7S , RANGE 31E , W. M.

North

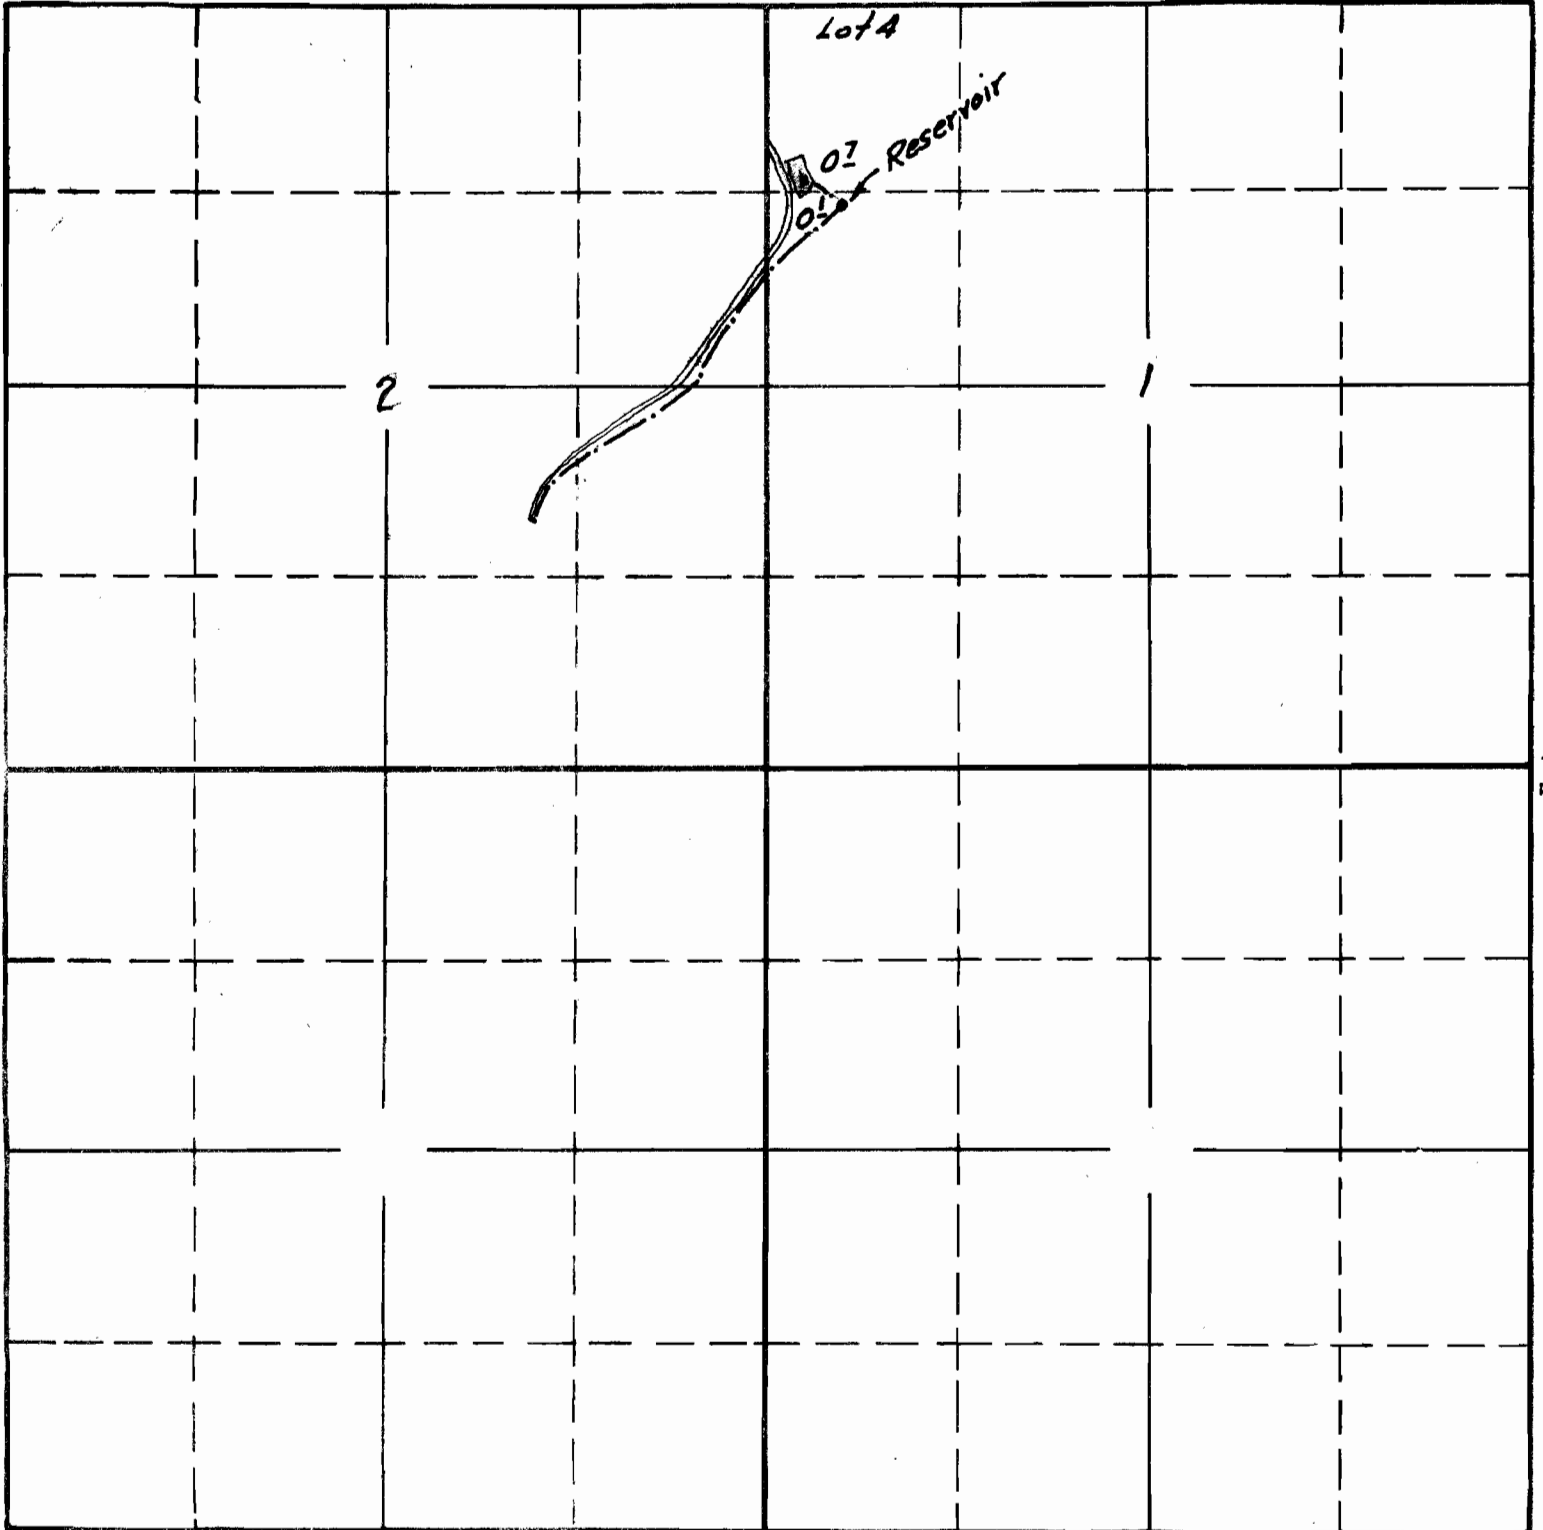

South

16367  
APPLICATION No. 16398  
PERMIT No. 12198  
R690