


SECTION

19

TOWNSHIP 24S, RANGE 9E, W. M.

North

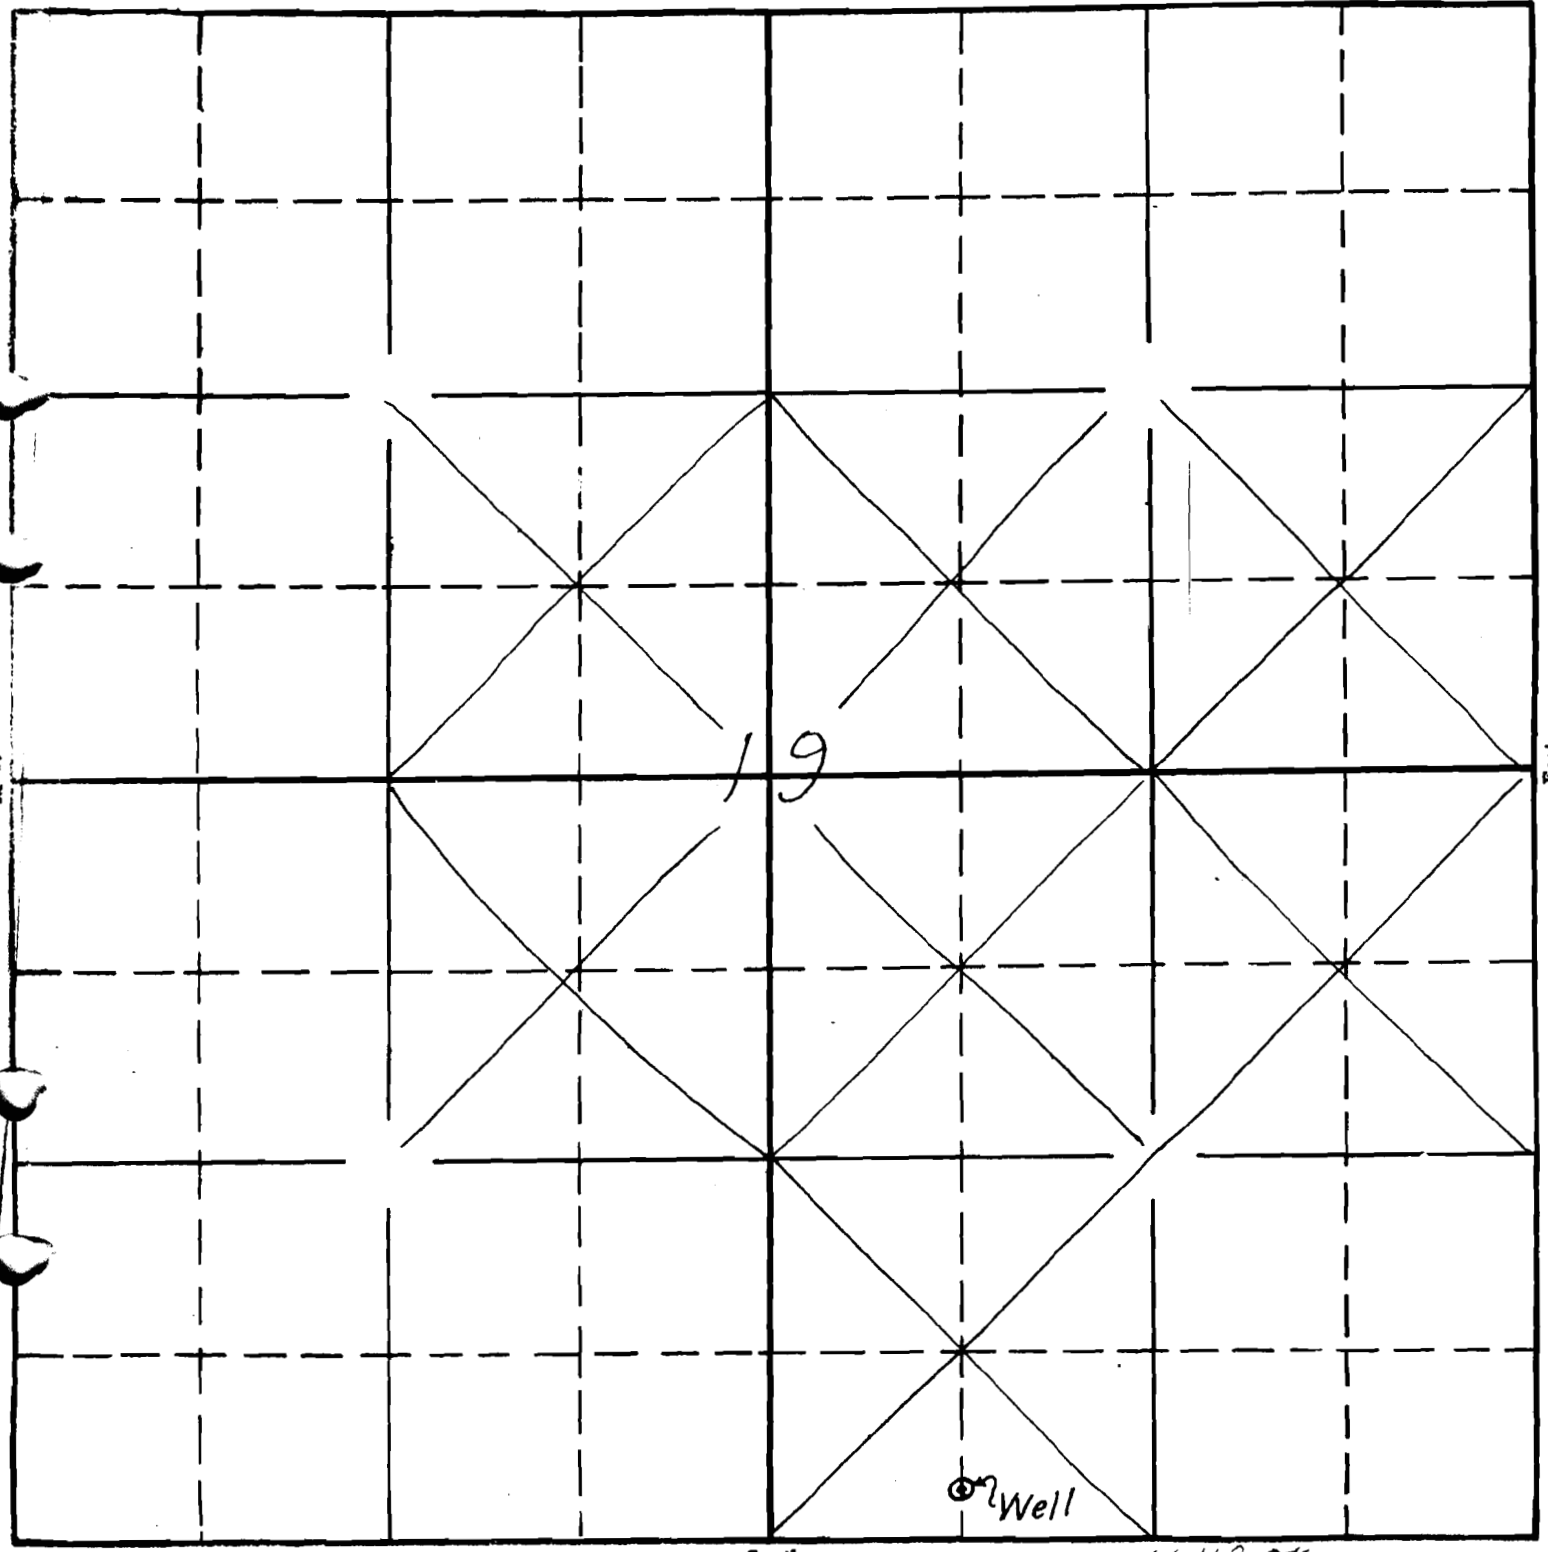

South

Sketched in office of State Eng from data, by Mr. B.V. Wright 2/27/39.

U 118 OK
5-20
APPLICATION No. U-118
PERMIT No. U-112

40 acre tracts in which water is used are designated thus ☒

Scale
1 in = 660 ft.

U-112