


SECTION
23

U-92
C-12509

TOWNSHIP 6N, RANGE 35E, W. M.

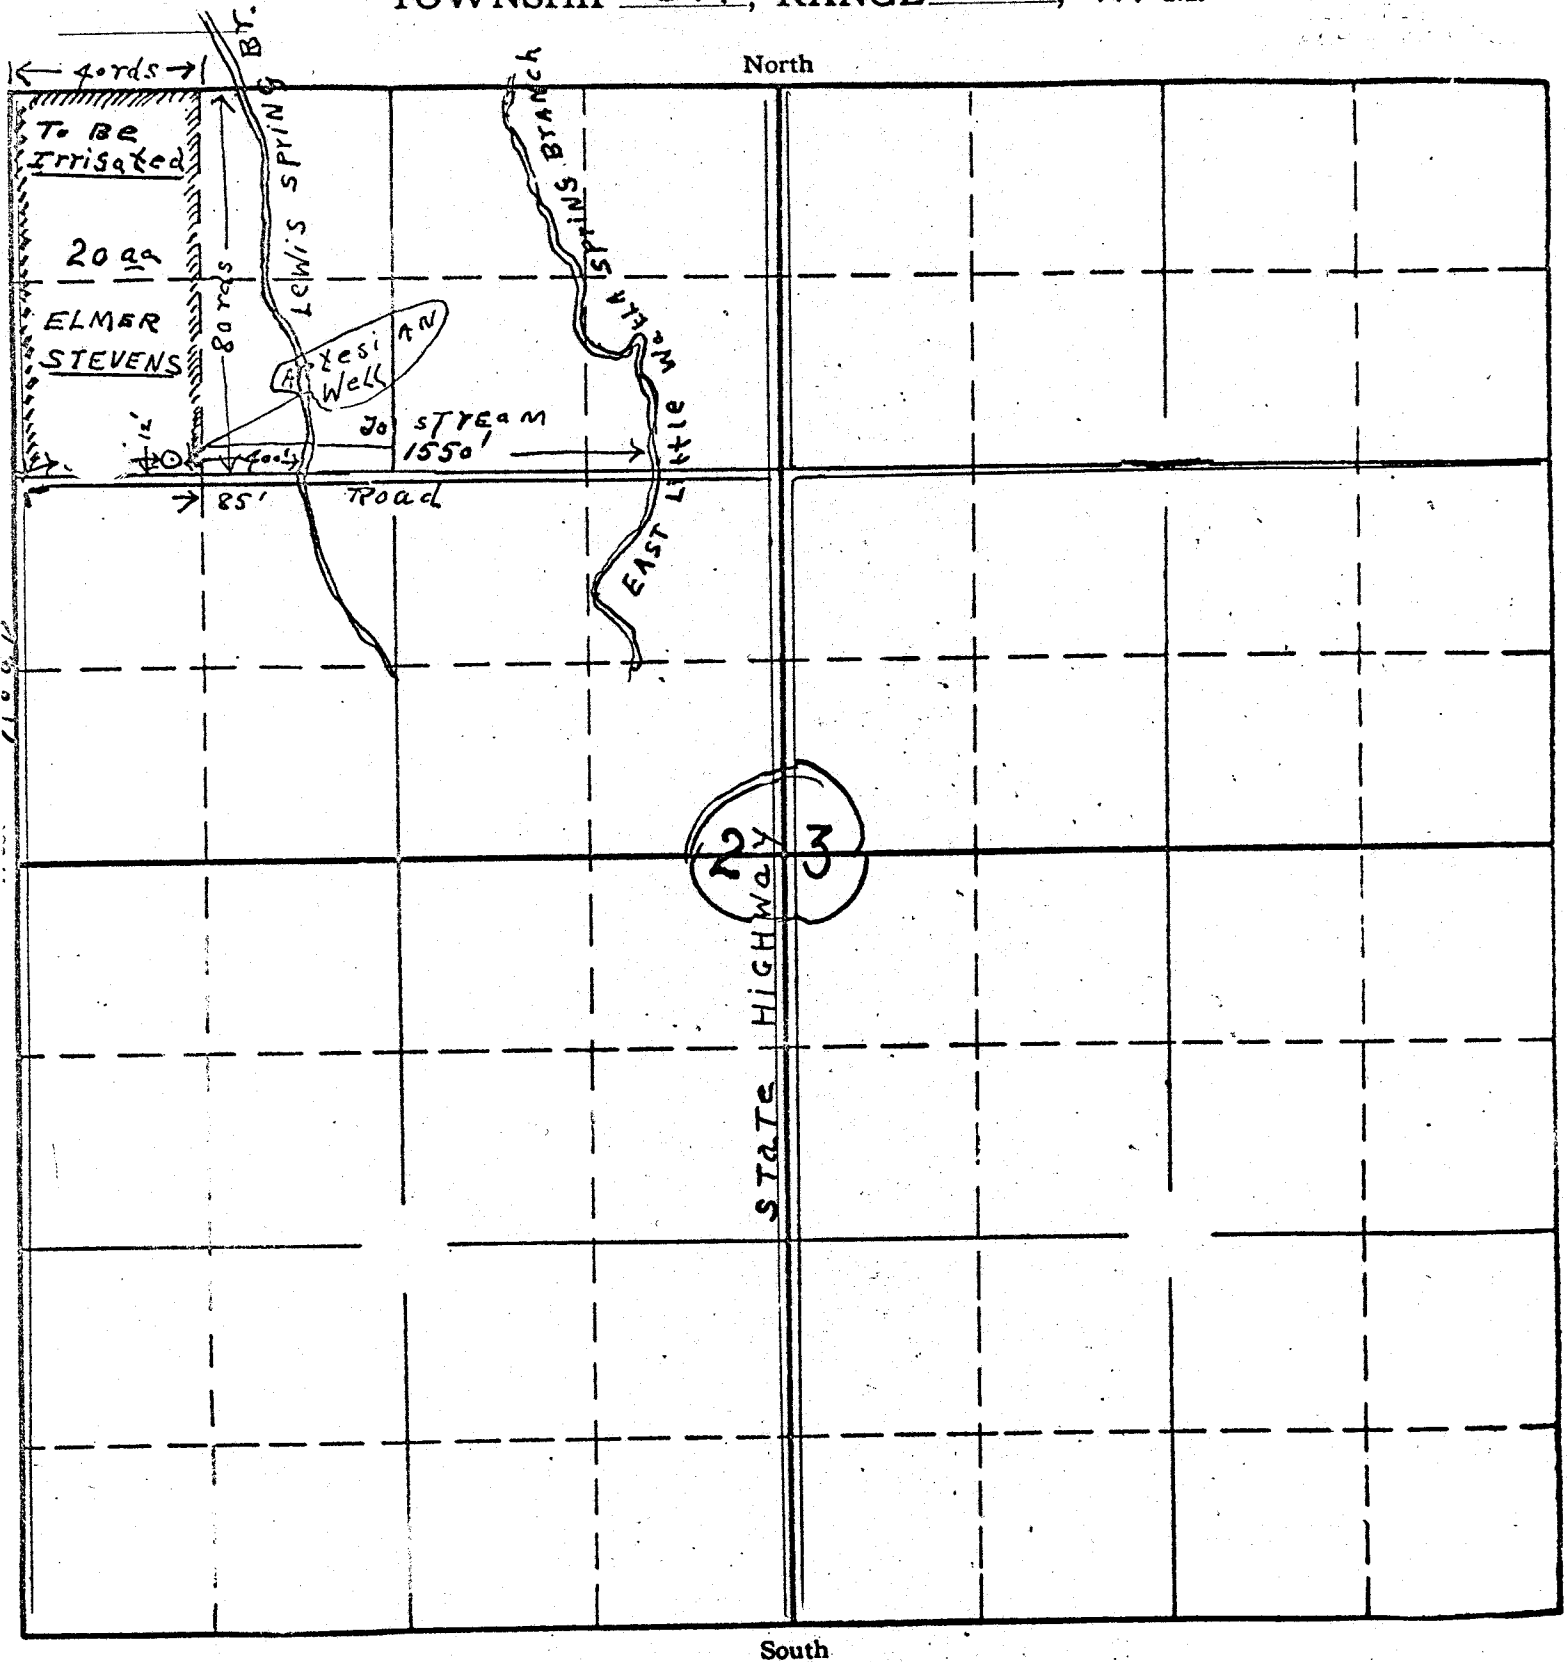

APPLICATION OF Elmer Stevens
For Permit for Artesian Well

APPLICATION No. U-99
PERMIT No. U-92

Scale - 8 IN = 1 Mile