


ownship 33 S, Range 7 1/2 E.

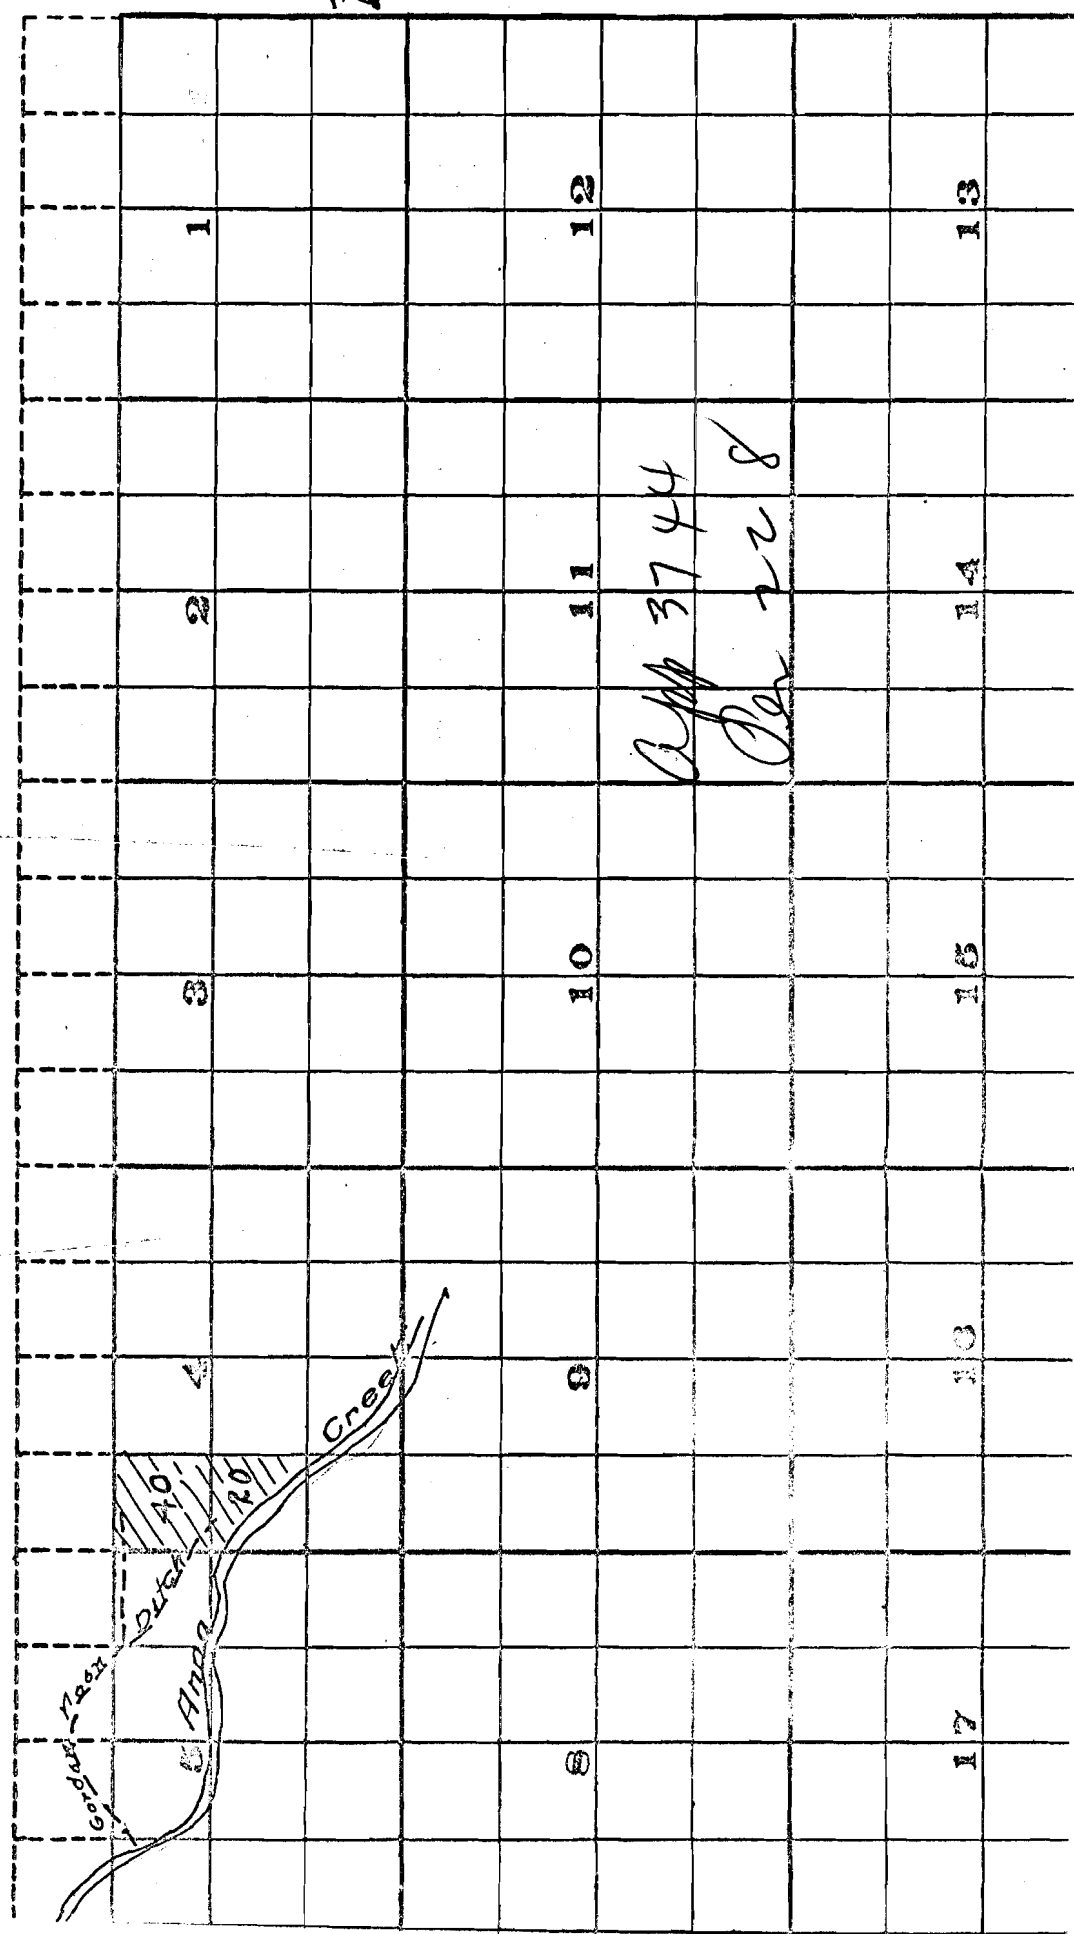

A-31
P 2

E-228
1265