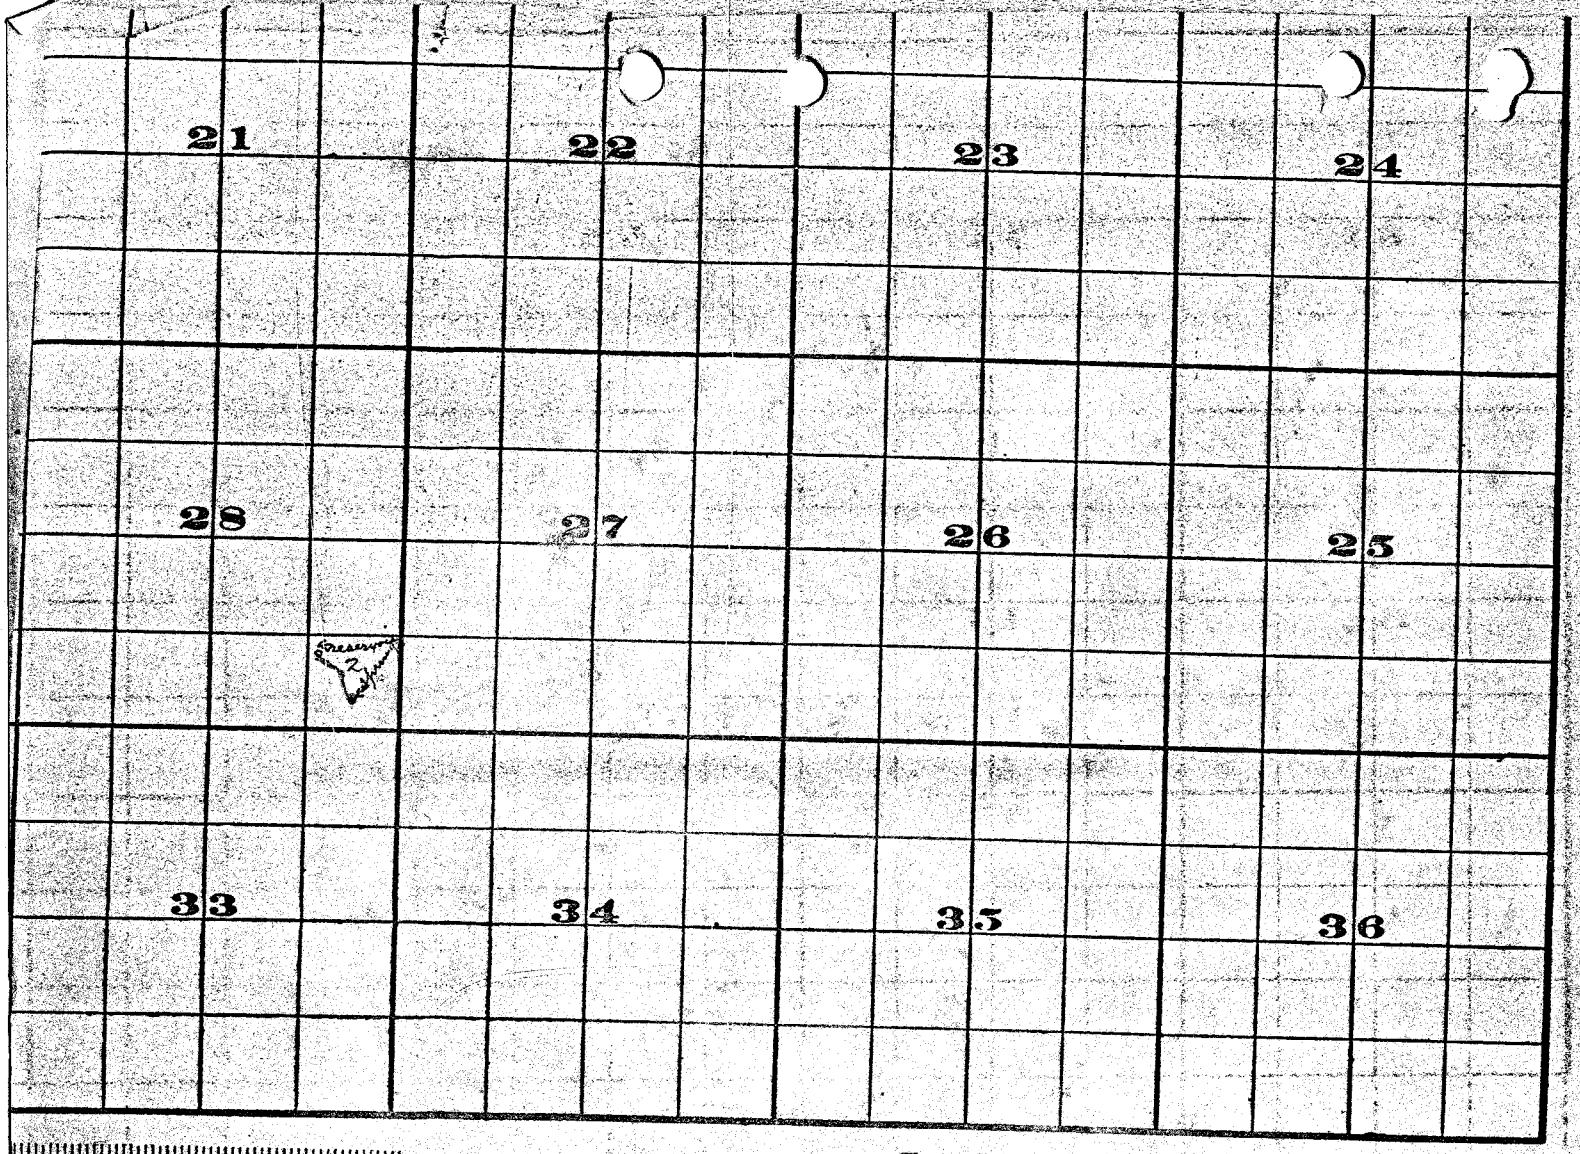

FROM OFFICE OF THE STATE ENGINEER, SALEM, OREGON

App 3731
Per 2087

T 9 S R 28 E

Per 2087