


Township 1-N, Range 10-E.

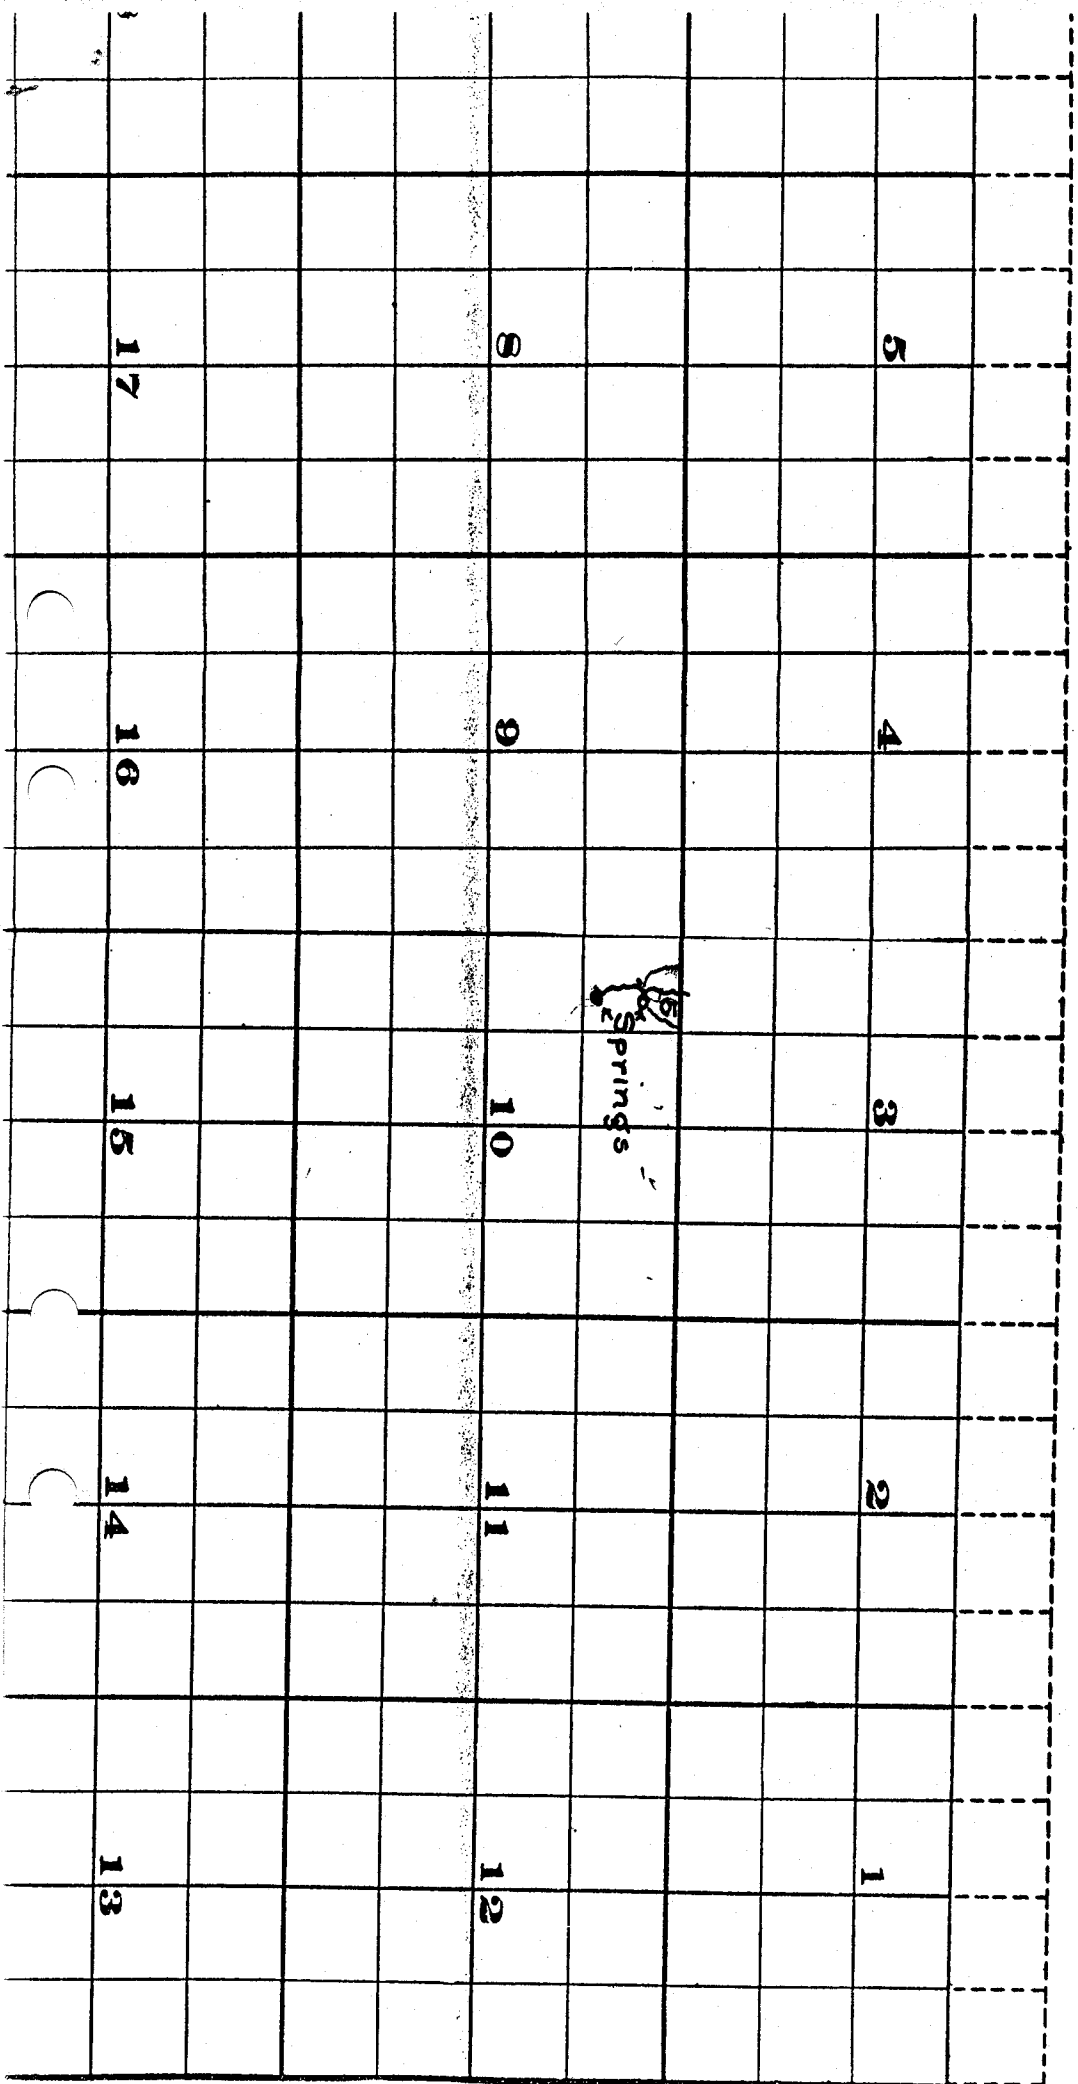

5695

Permit 2266

Township 1-N

Range 10-E

