


SECTION

11700
1332<

TOWNSHIP 15. , RANGE 24E , W. M.

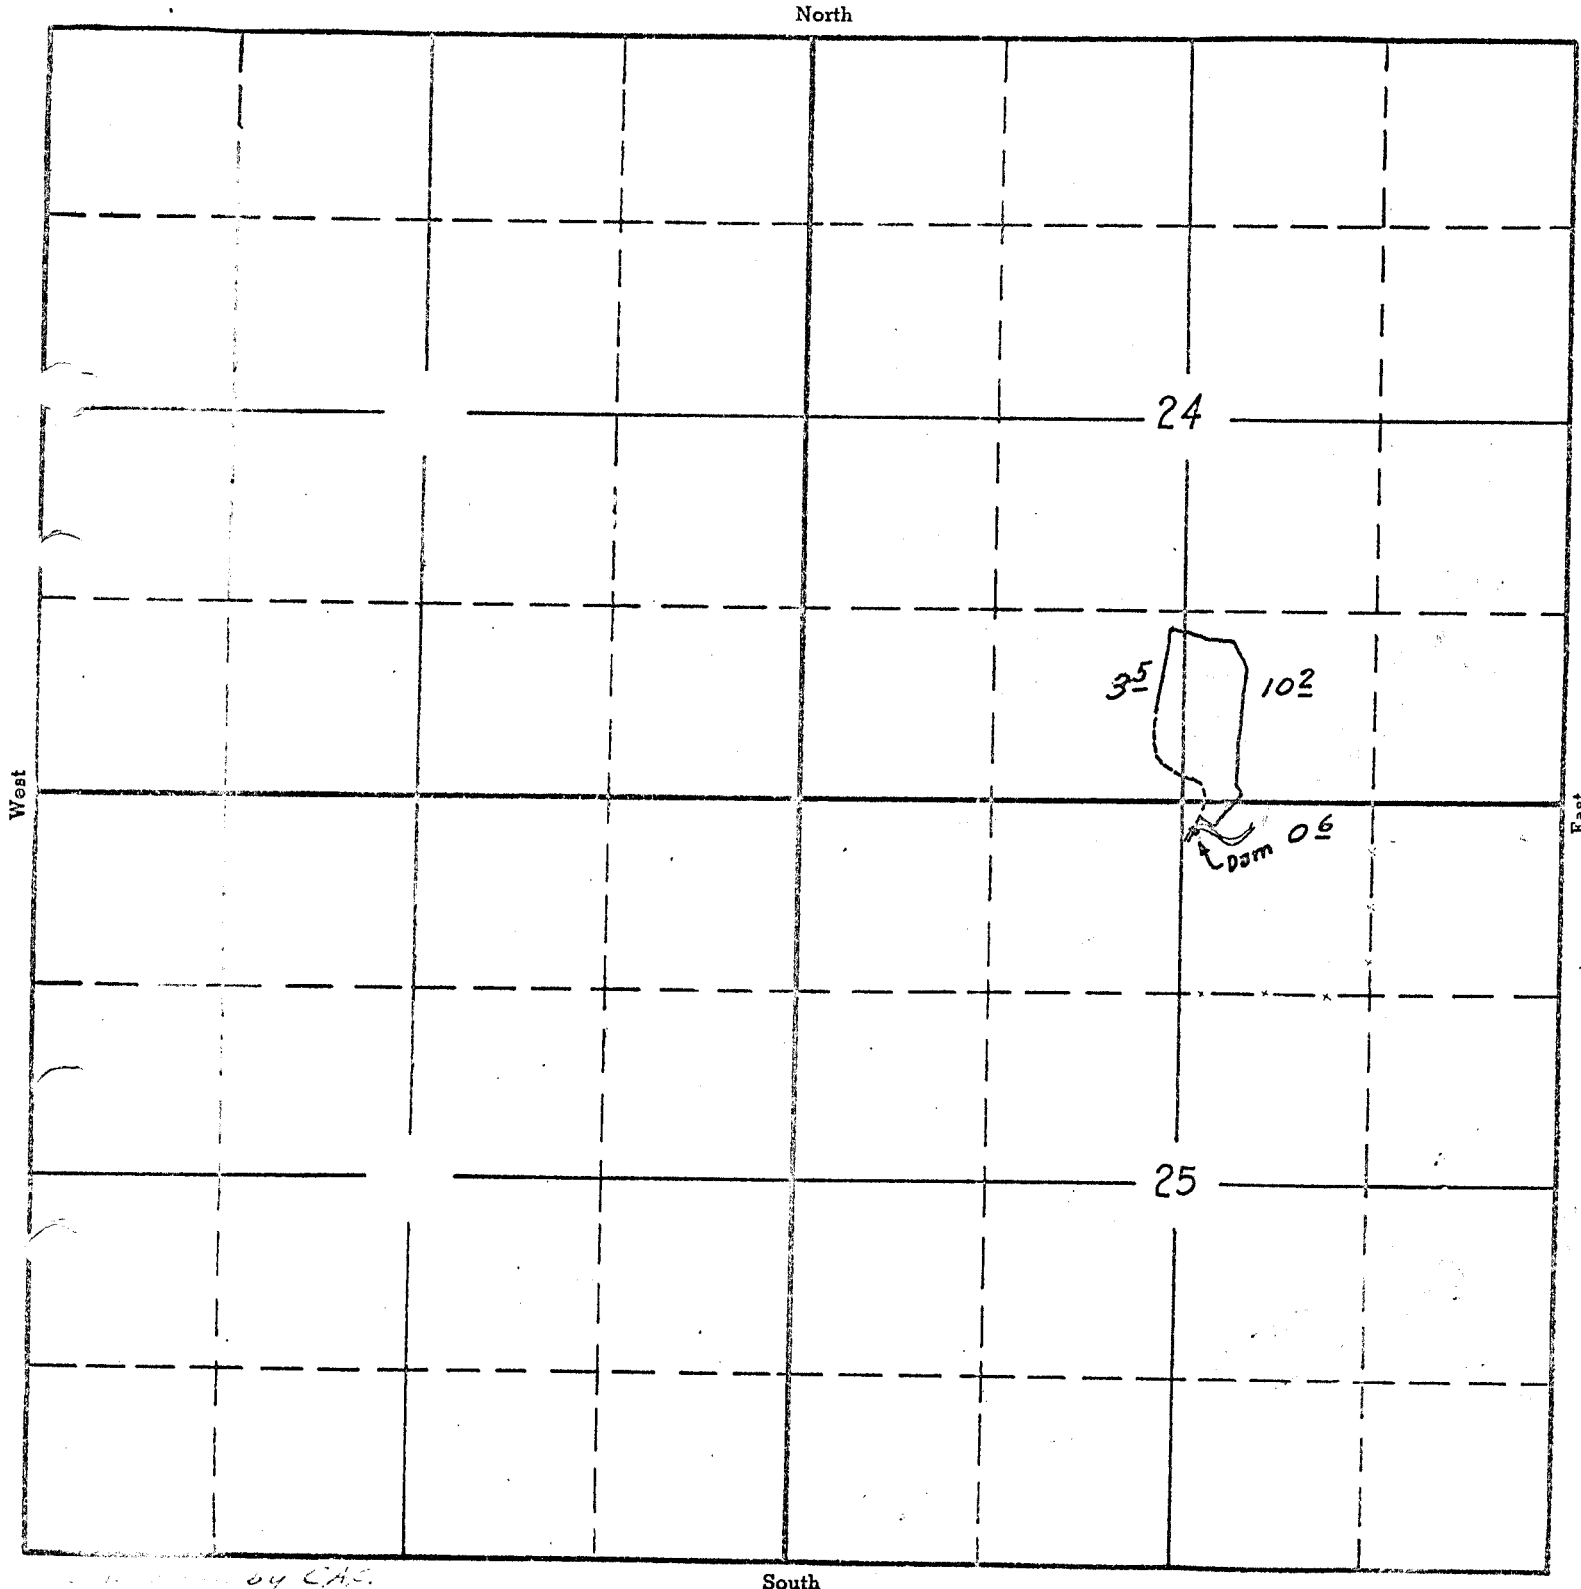

by C.A.S.
11/1/17

APPLICATION No. 15869 ✓
PERMIT No. 11700