


SECTION

7

TOWNSHIP 39, RANGE 14, W. M.

North

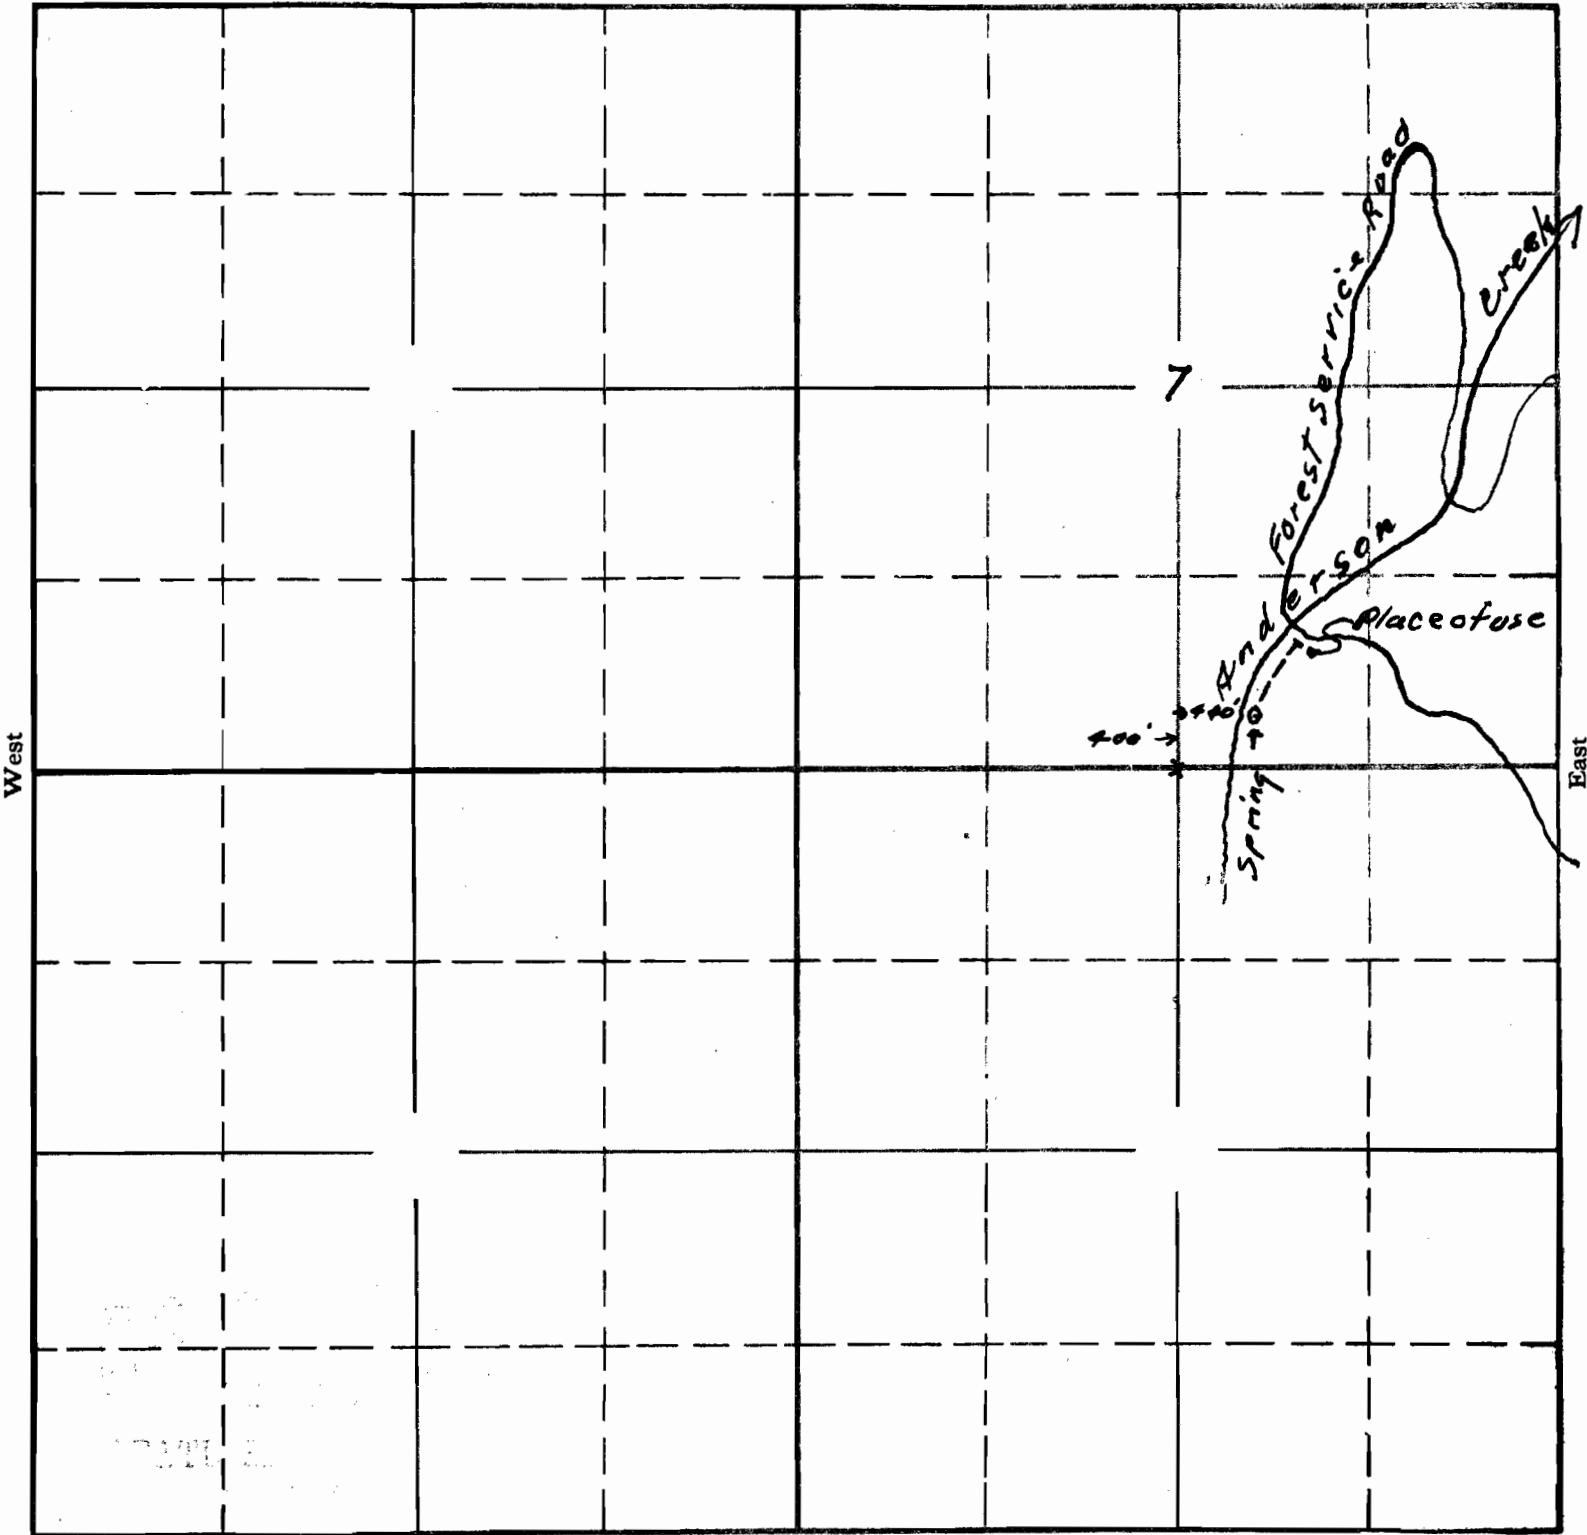

Sketch to accompany application of U.S. Forest Service for the use of Spring unnamed at head of Anderson Cr. for public drinking purposes

APPLICATION No. 16336
 PERMIT No. 12137