


TOWNSHIP 55 , RANGE 27E , W. M.

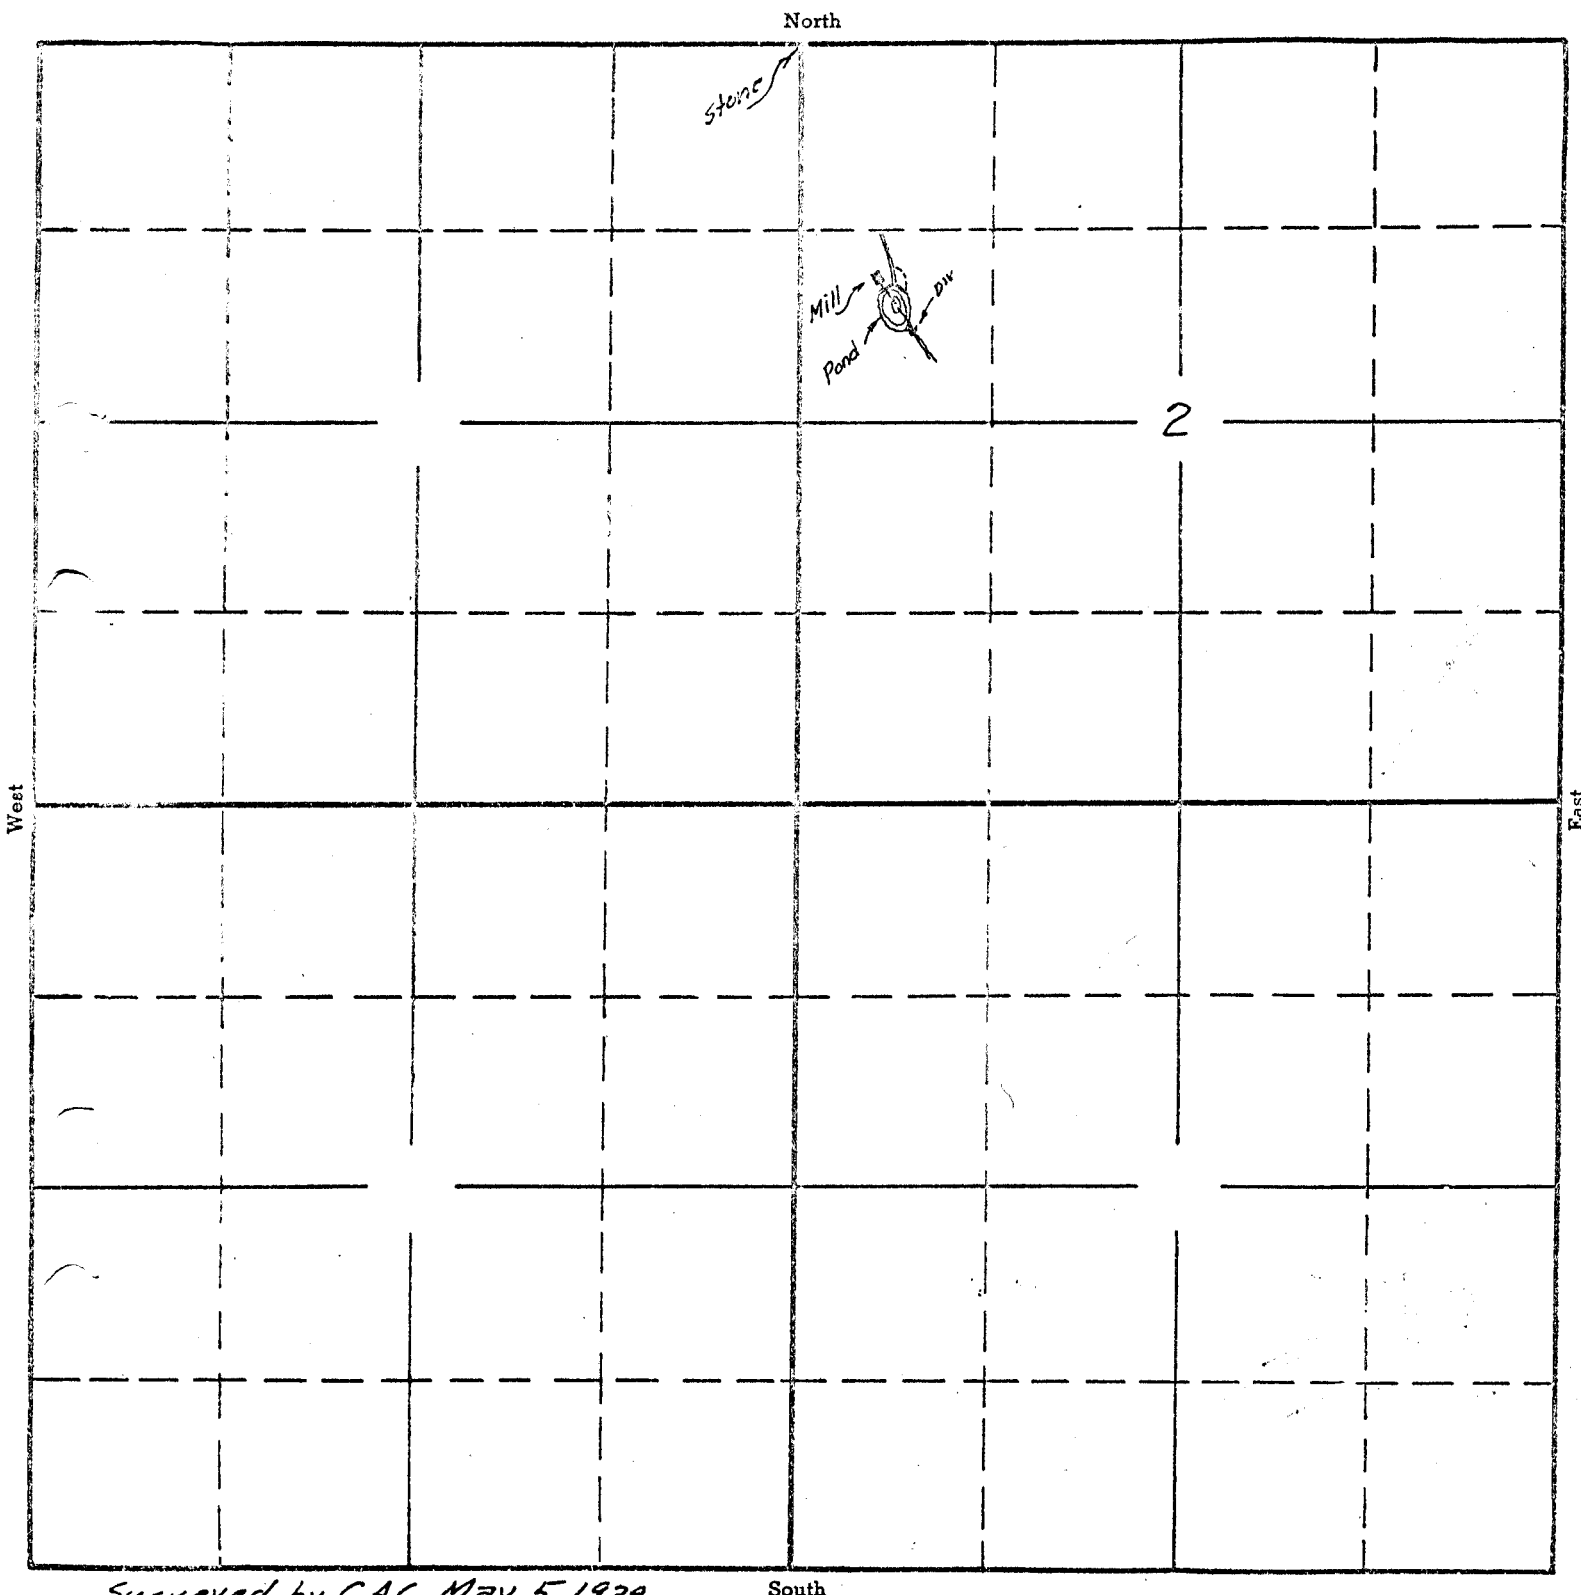

Surveyed by C.A.C. May 5 1939

APPLICATION No. 16878  
PERMIT No. 12636