


SECTION

32

12825

TOWNSHIP 14, RANGE 13E, W. M.

North

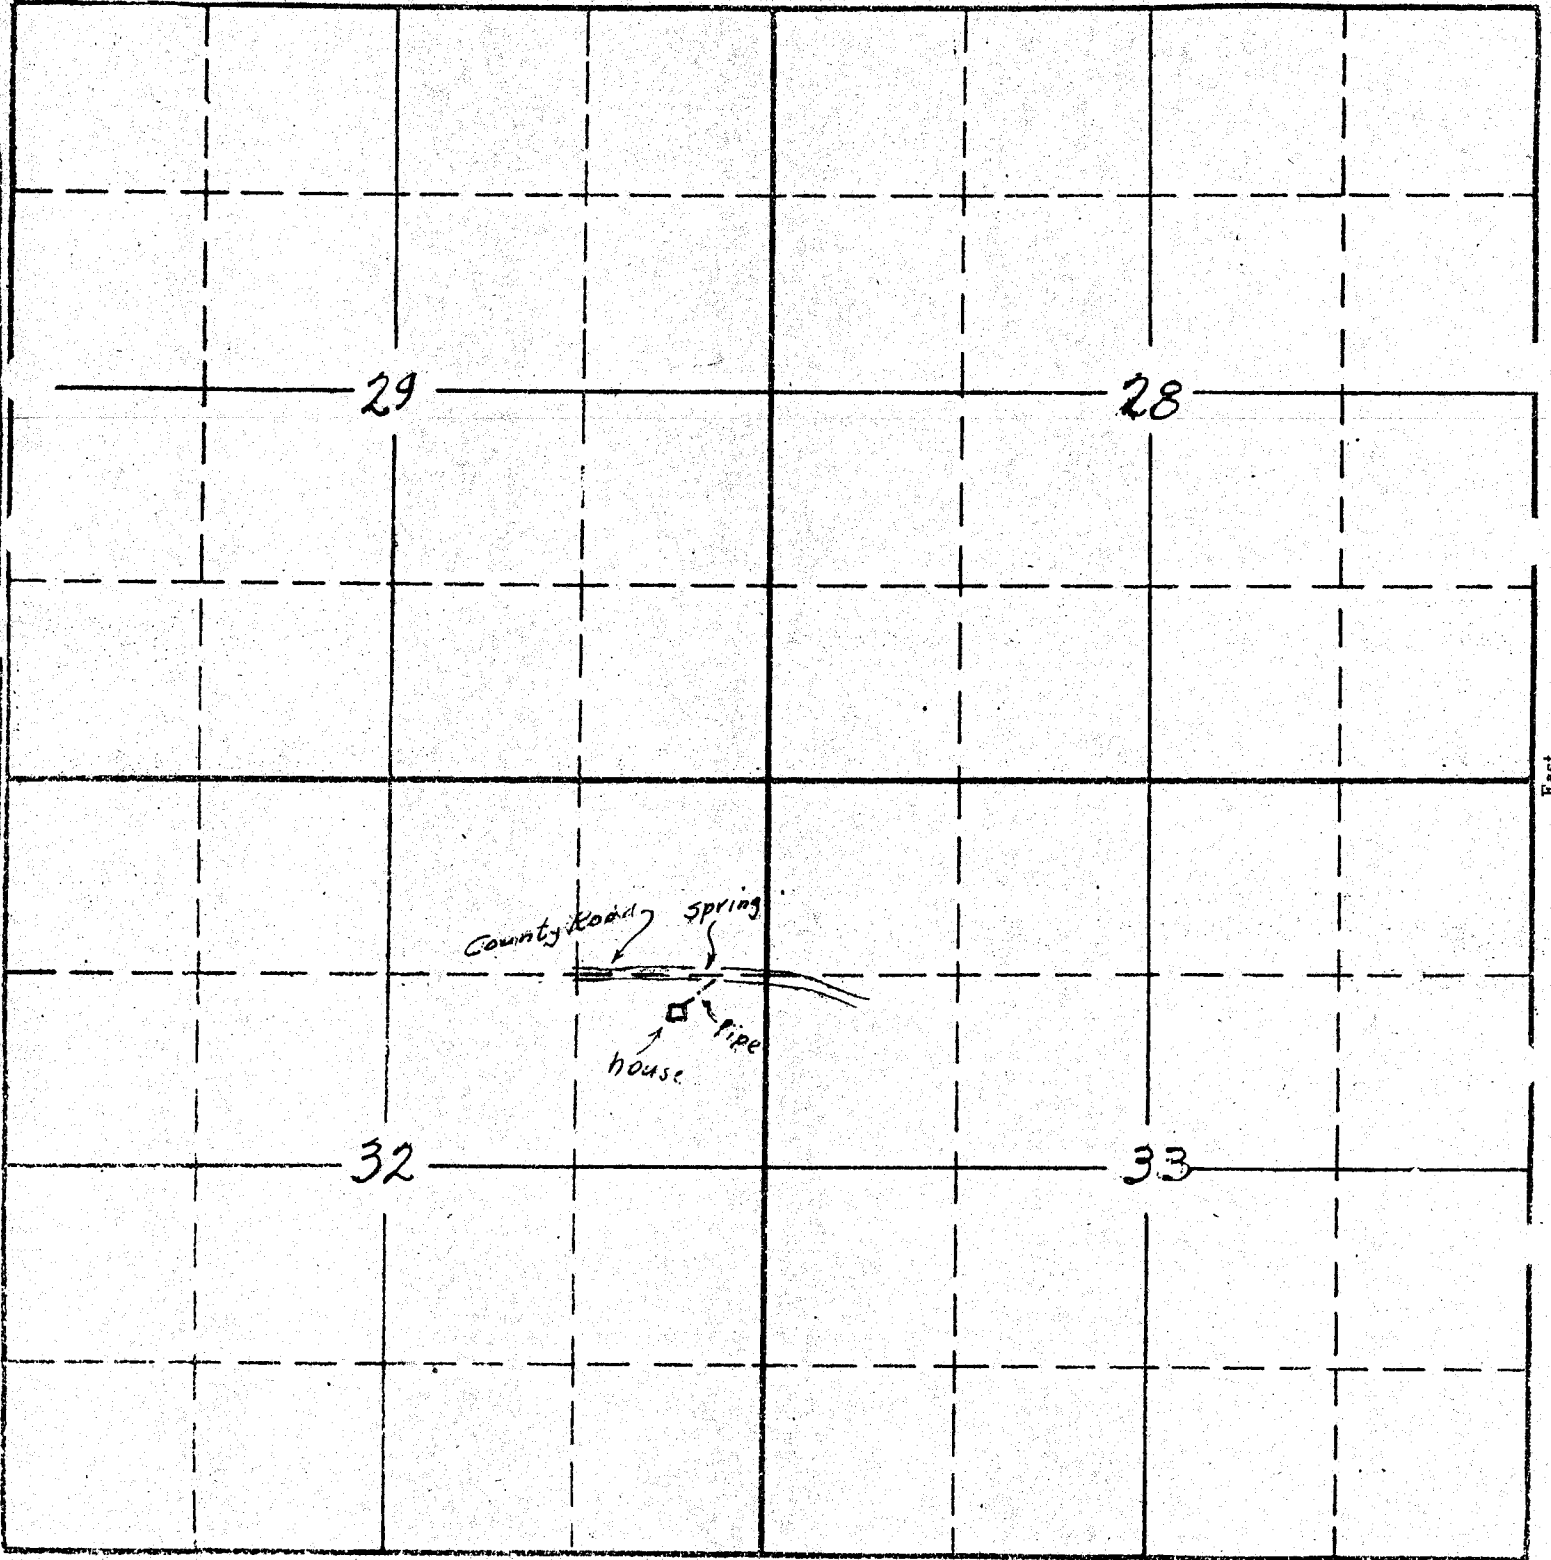

South

16988 cr
4-5

APPLICATION No. 16988

PERMIT No. 12825

SALVAGE