


TOWNSHIP 2N, RANGE 11E, W. M.

North

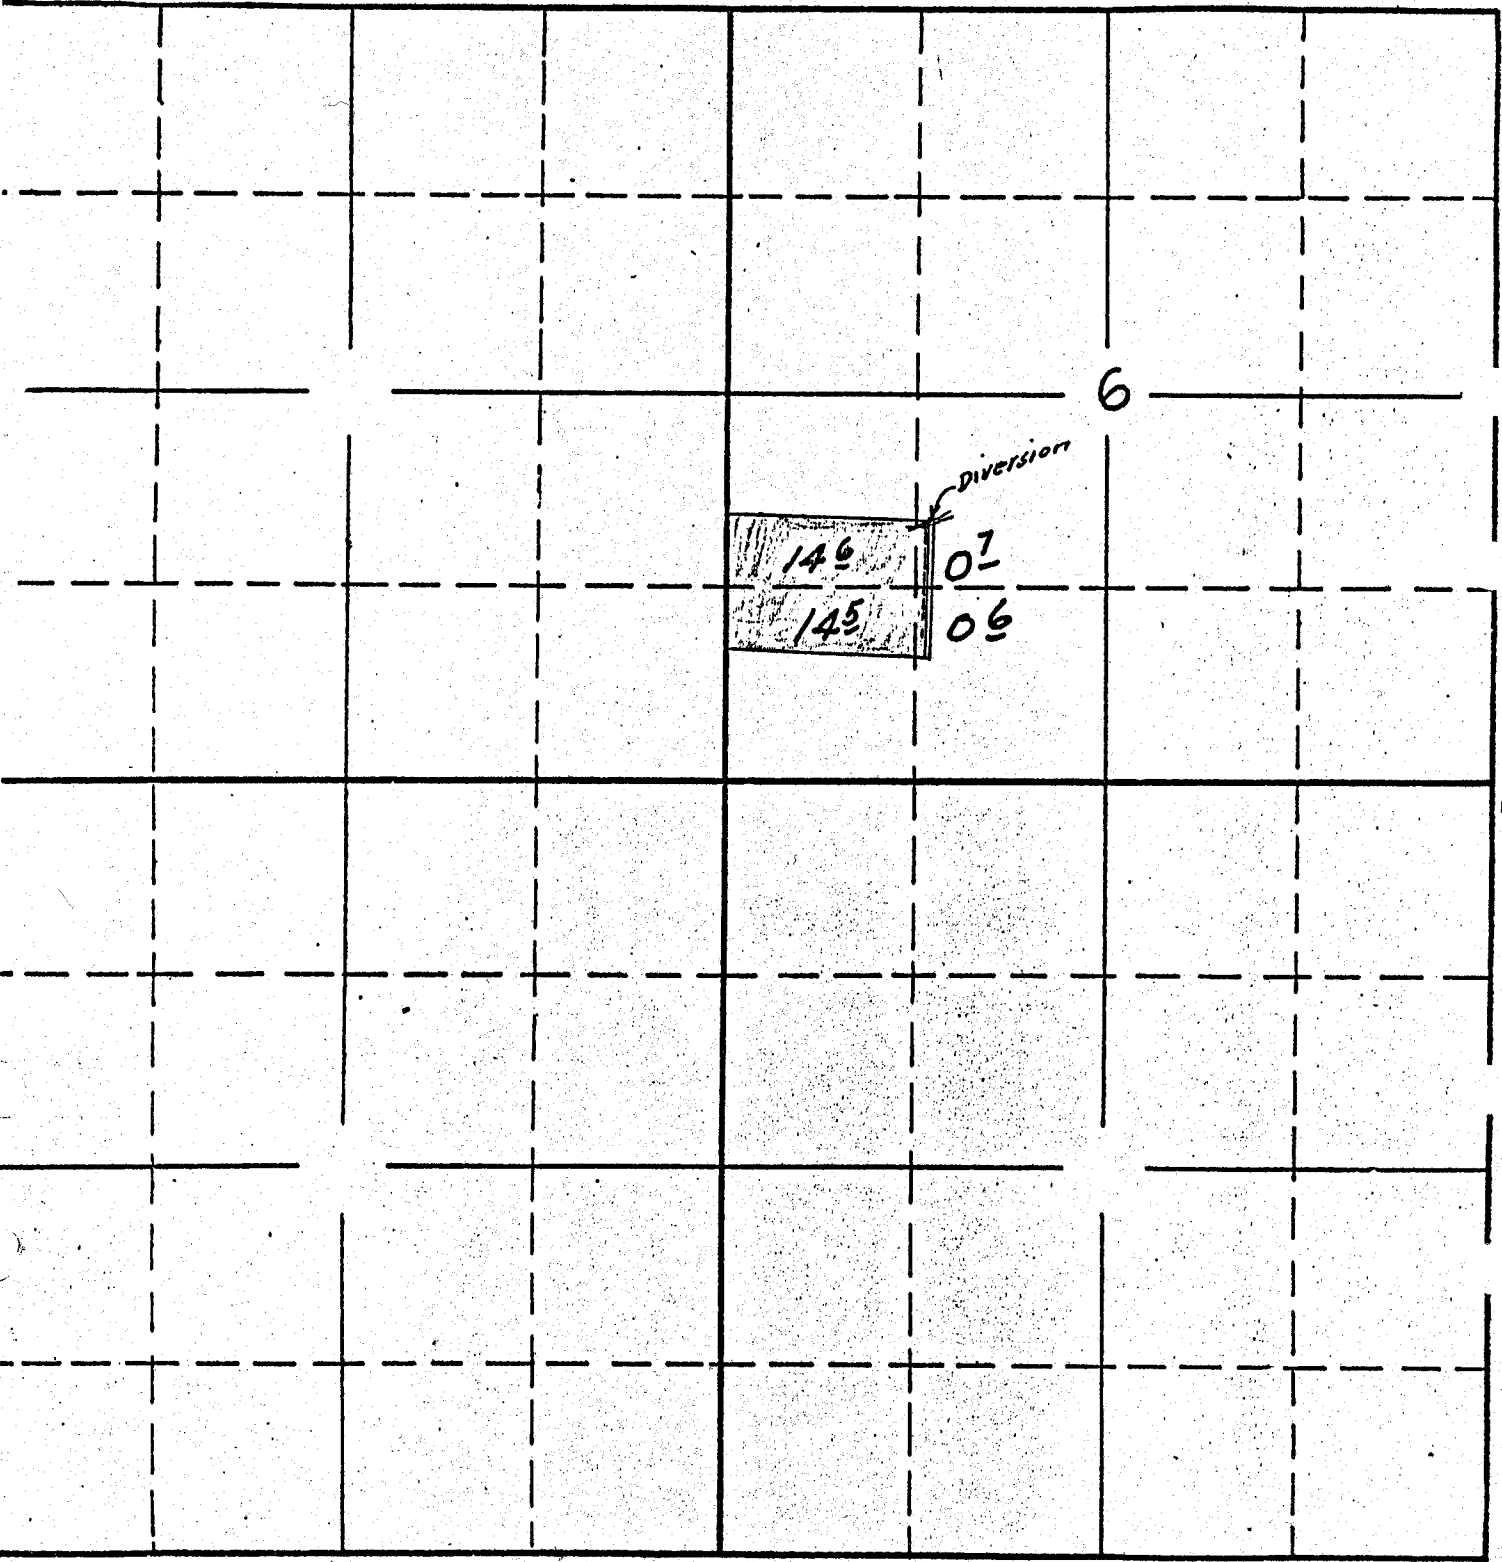

Surveyed by CAC. May 2 1939

South

APPLICATION No. 1784
PERMIT No. 12815