


SURVEYORS CERTIFICATE

I, W.E. Anderson Deputy County Surveyor of Tillamook, Oregon do hereby certify that map was made from notes taken during an actual survey made by me August 12, 1938, and that it correctly represents the work herein shown.

Deputy Co. Survr.
W.E. Anderson

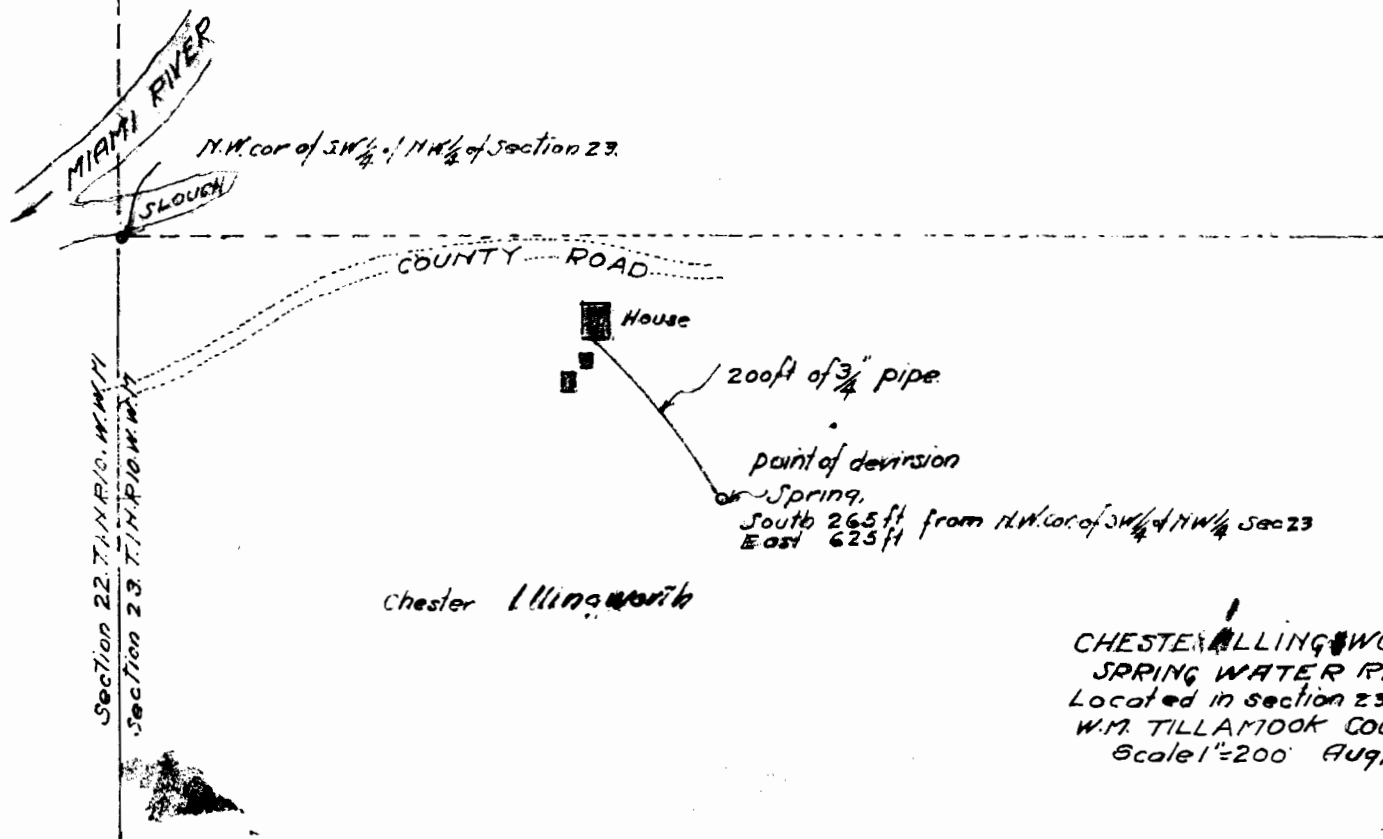

Chester Illingworth

CHESTER ILLINGWORTH
SPRING WATER RIGHT
Located in section 23 T.1N.R.10.W
W.M. TILLAMOOK COUNTY ORE
Scale 1"=200' Aug, 1938.

W.E. Anderson

17571

1347