


13425
13426

Plat Showing Location and Place of Use
Permits No. 14312 and No. 14313 T.18S. R8E. W.M.
Elk Lake Resort and Elk Lake Guard Station
United States Forest Service-Deschutes National Forest
Surveyed by A.E. Perry and J. H. Ryan - Aug. 21, 1940
Platted by Donald E. Garvik - Sept. 17, 1940
Scale: 1" = 400 ft.

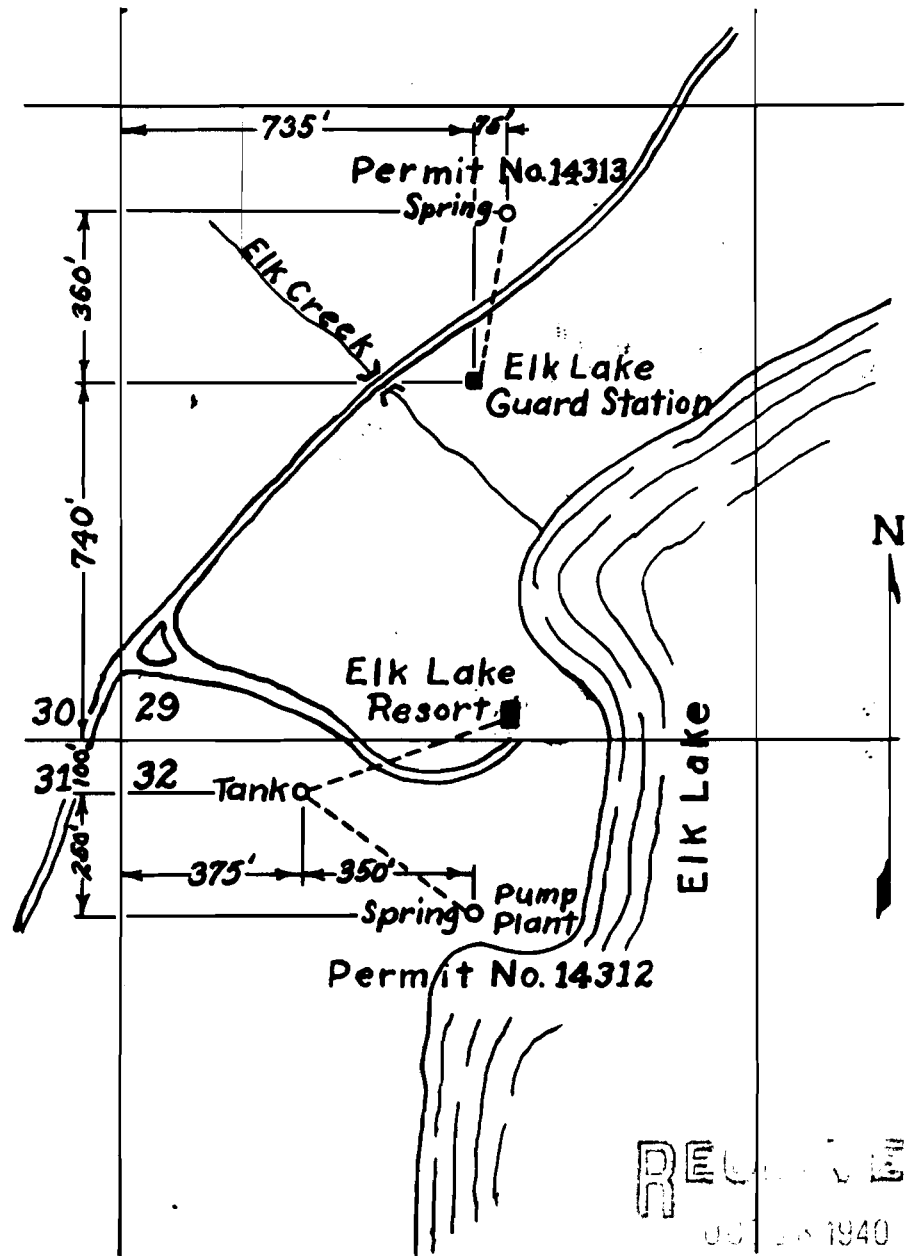

RECORDED
JUL 26 1940
STATE ENGINEER
SALEM, OREGON

App # 18683, 18684
Per. # 14312, 14313

2
14312
14313