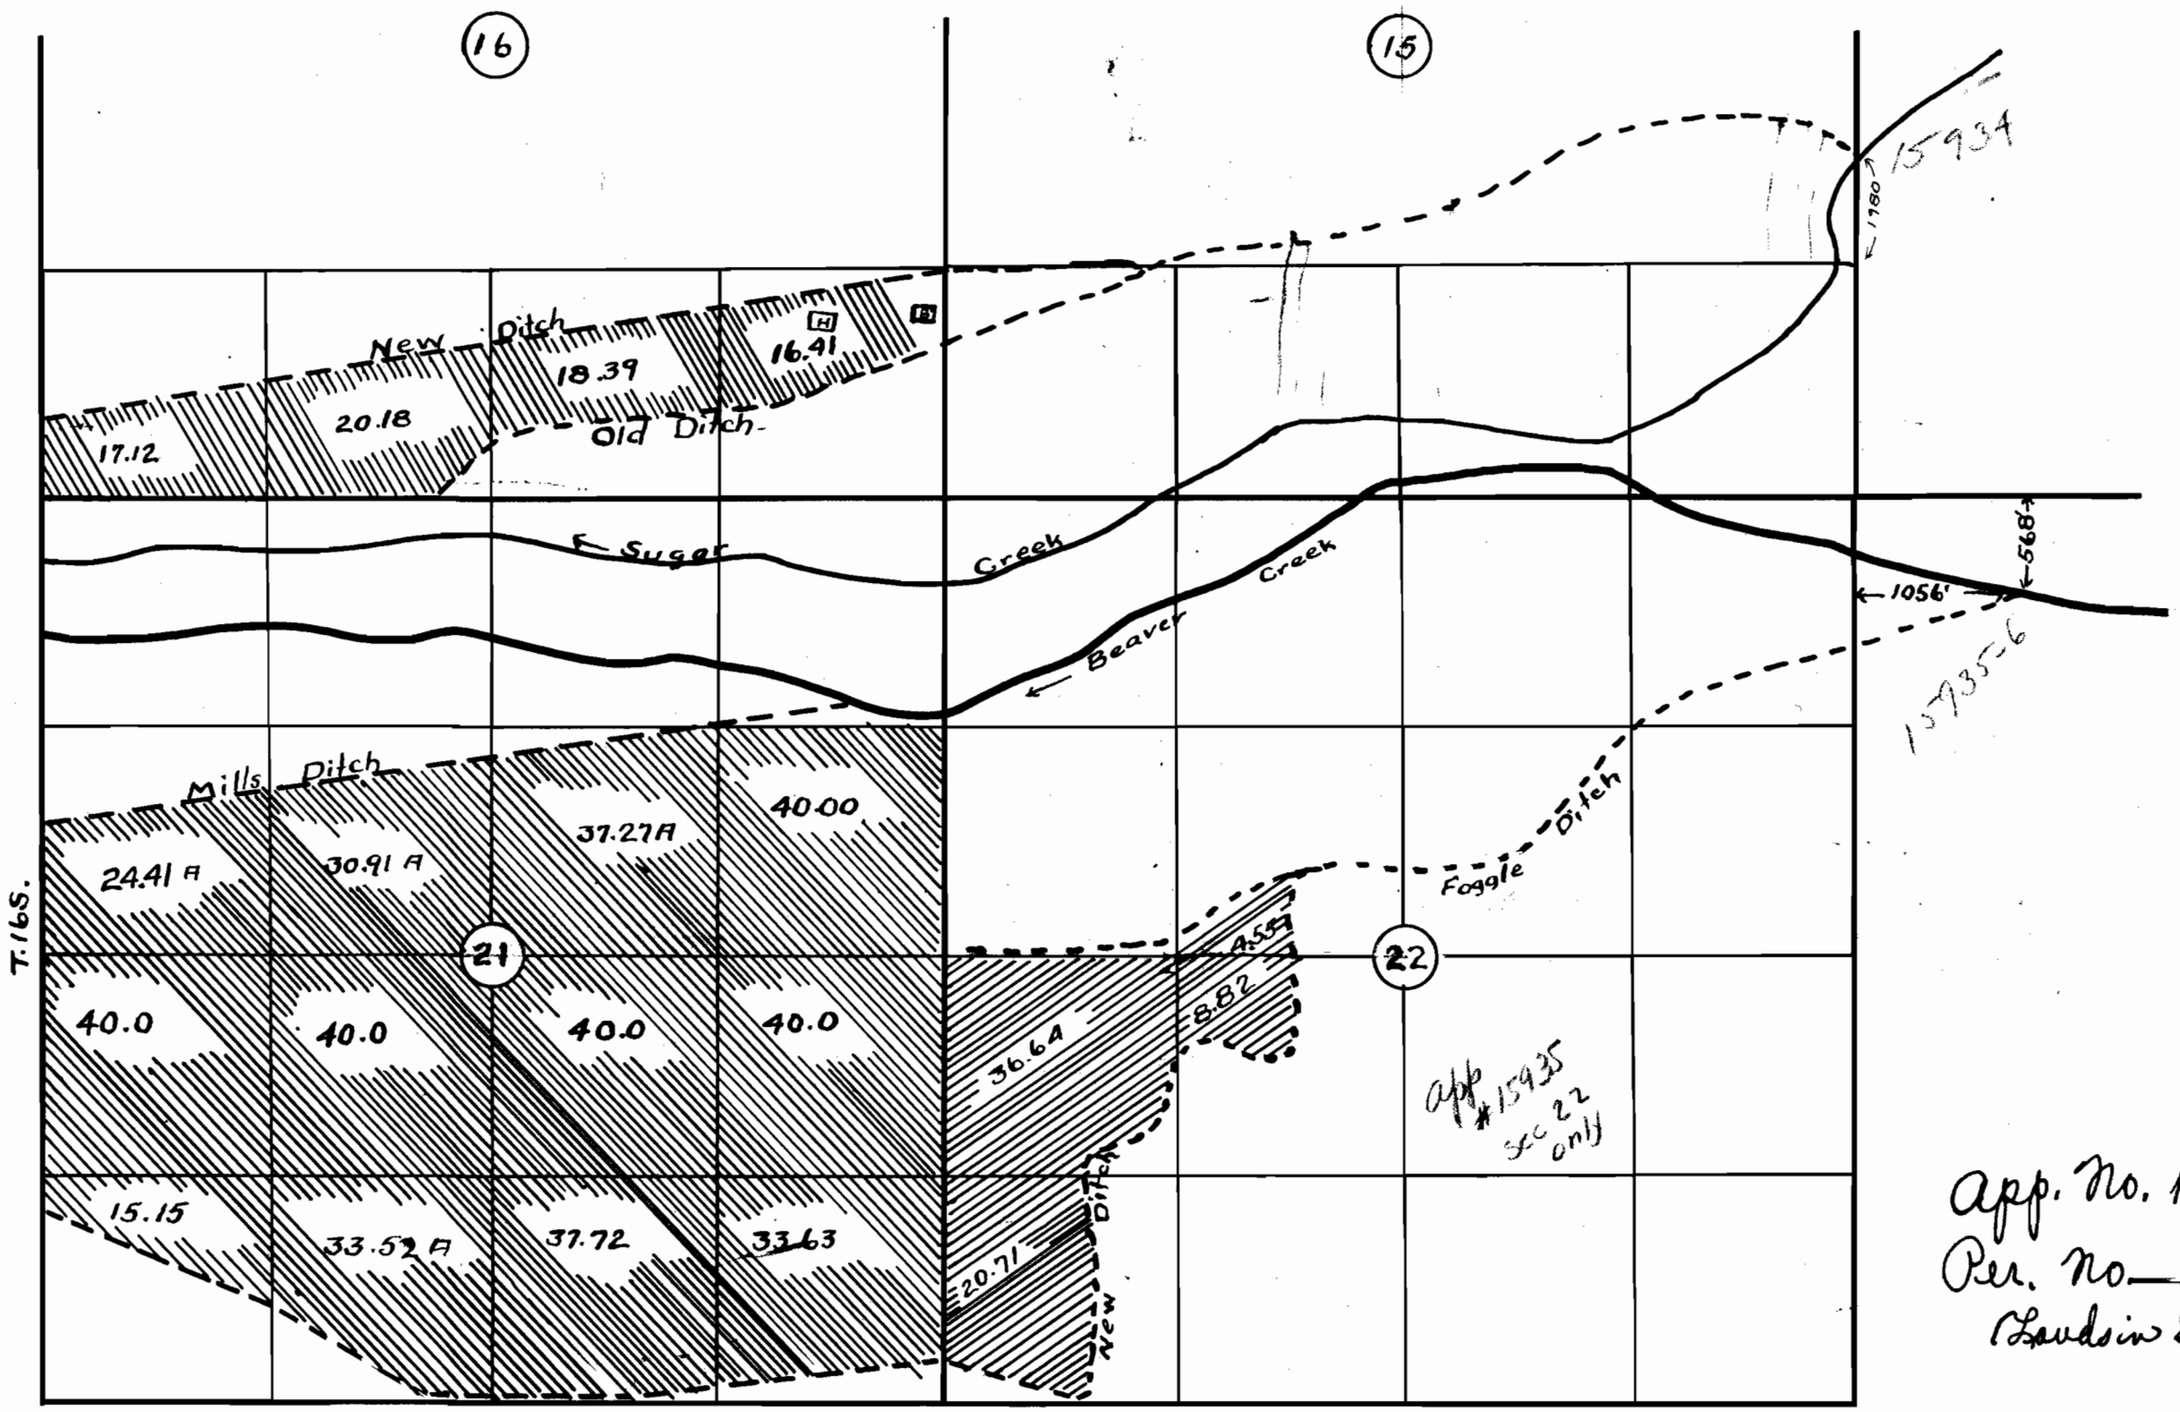

R 24 E. Scale 1" = 1000 Ft.

App. No. 15936
Per. No. 11759
(Lands in Sec. 21 only)

I, C.W. Woodruff, of Prineville, Ore., do hereby certify that this map was made from notes taken during an actual survey made under my immediate supervision on June 20th, 1935 and that it correctly represents the works described in the accompanying application together with location of streams and other ditches in the immediate vicinity.

15935-6

C W Woodruff

Ore. No. _____

C W Woodruff
Registered Professional Engineer.

Date of Registration.

5-5-OK