


SECTION

TOWNSHIP 9 S, RANGE 3 W, W. M.

North

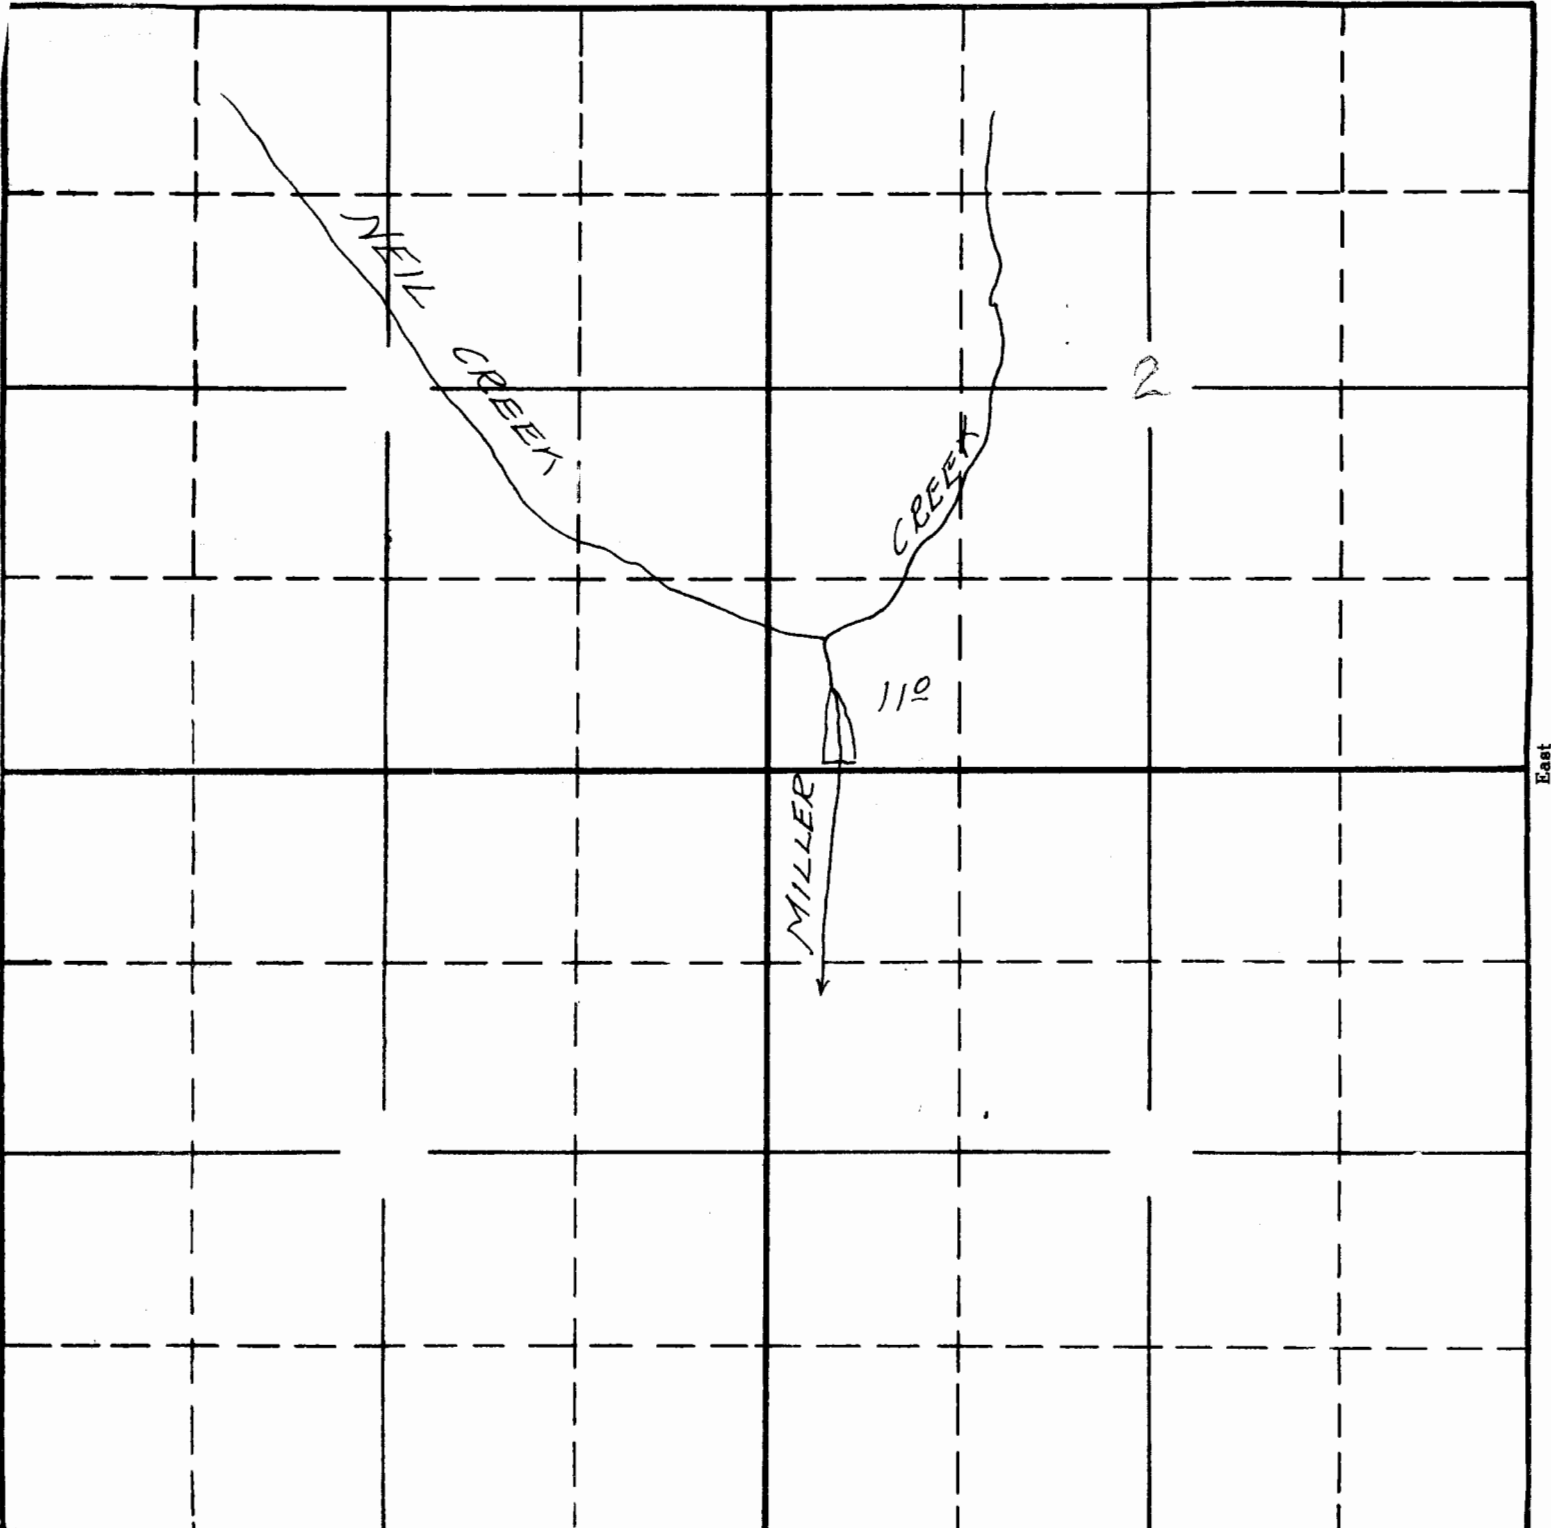

South

Traced from map
 accompanying app# 16810,
 per. # 12577

8-2-'39.

R18309 OK
 2-764
 APPLICATION No. R-18309
 PERMIT No. R-737