


TOWNSHIP 55 , RANGE 4W , W. M.

North

West

East

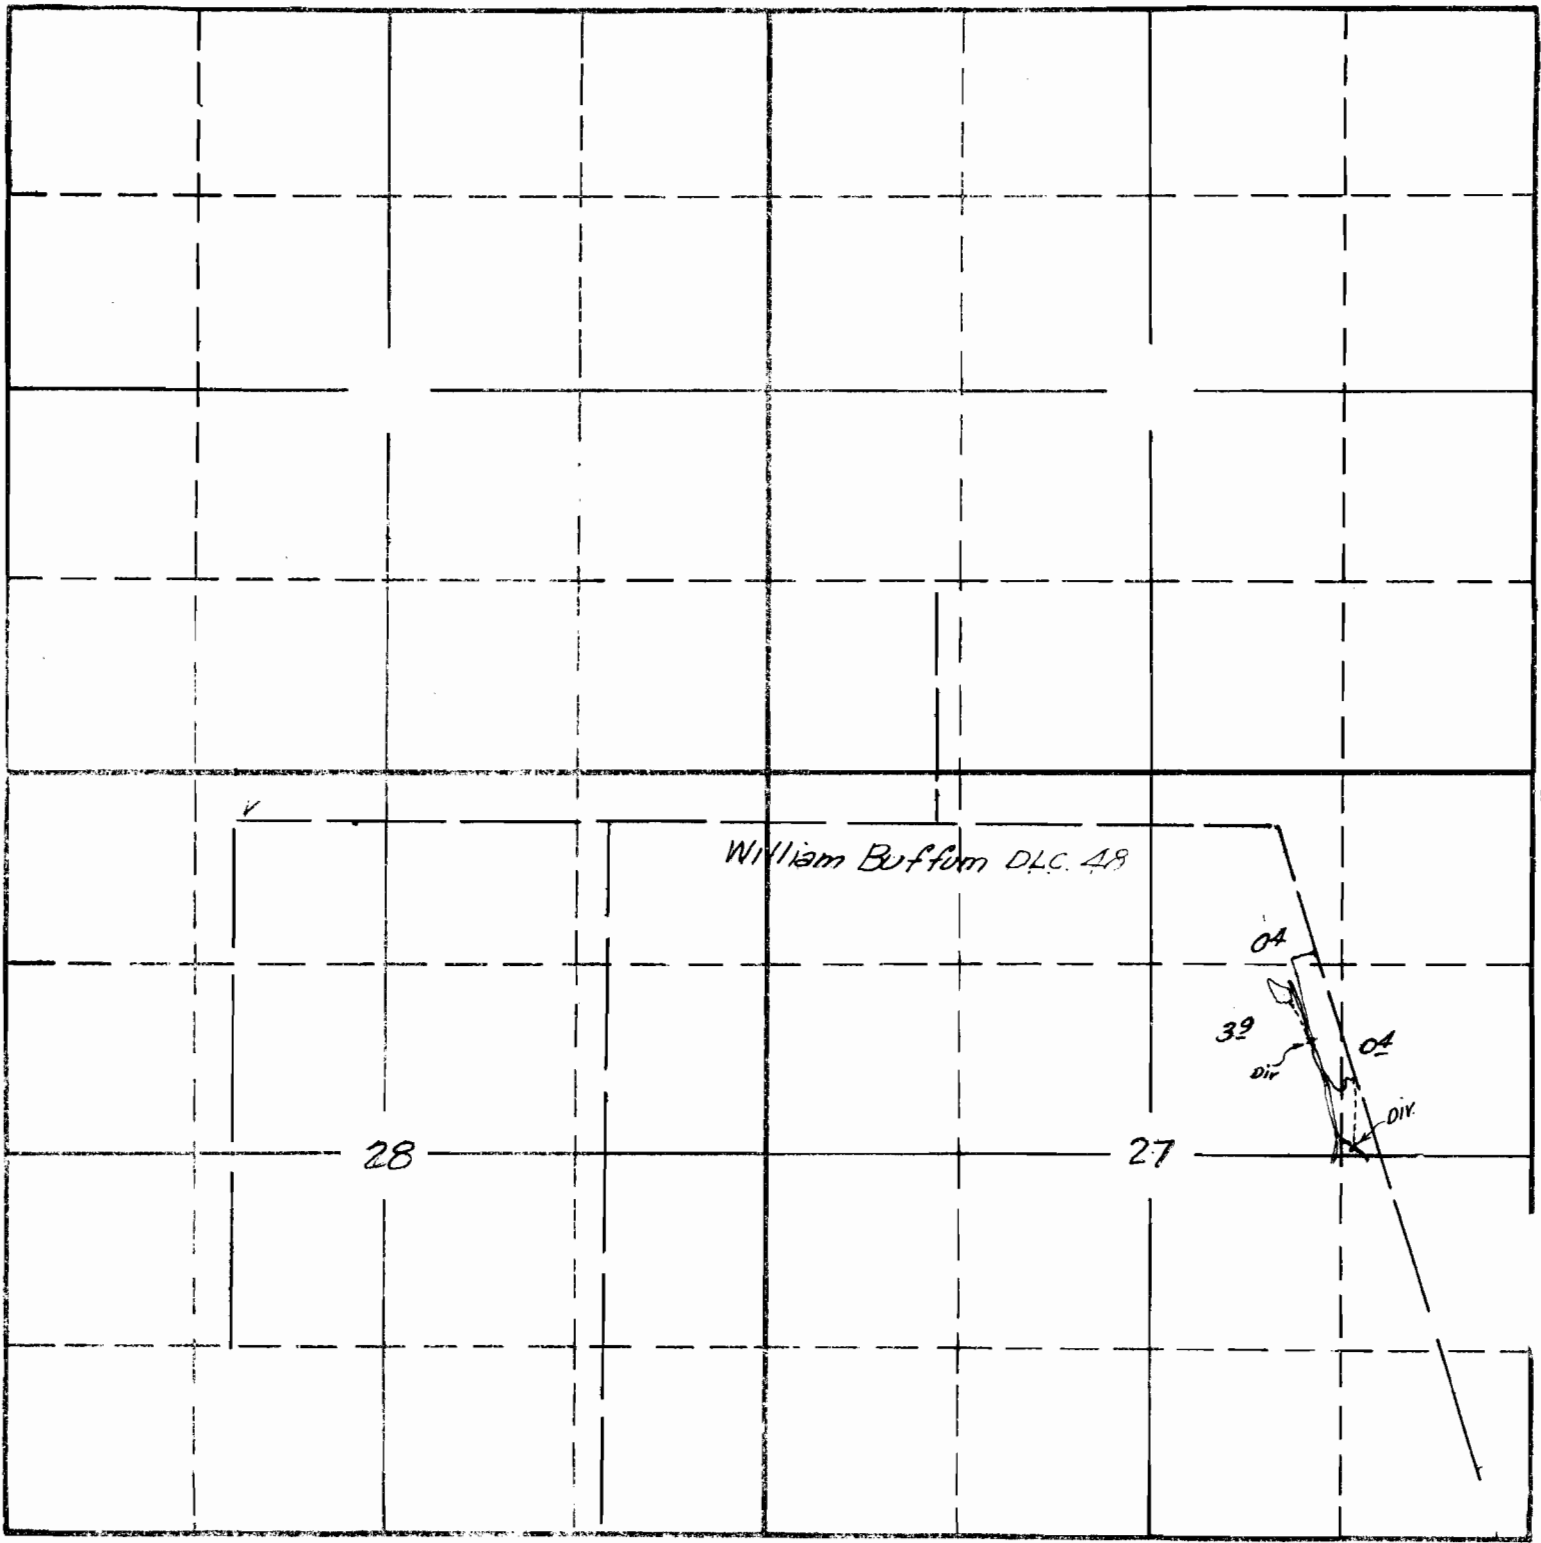

South

Surveyed 1938-1939 G.M.G.

APPLICATION No. 15727


PERMIT No. 11593

SECTION

27

TOWNSHIP 55, RANGE 4W, W. M.

North

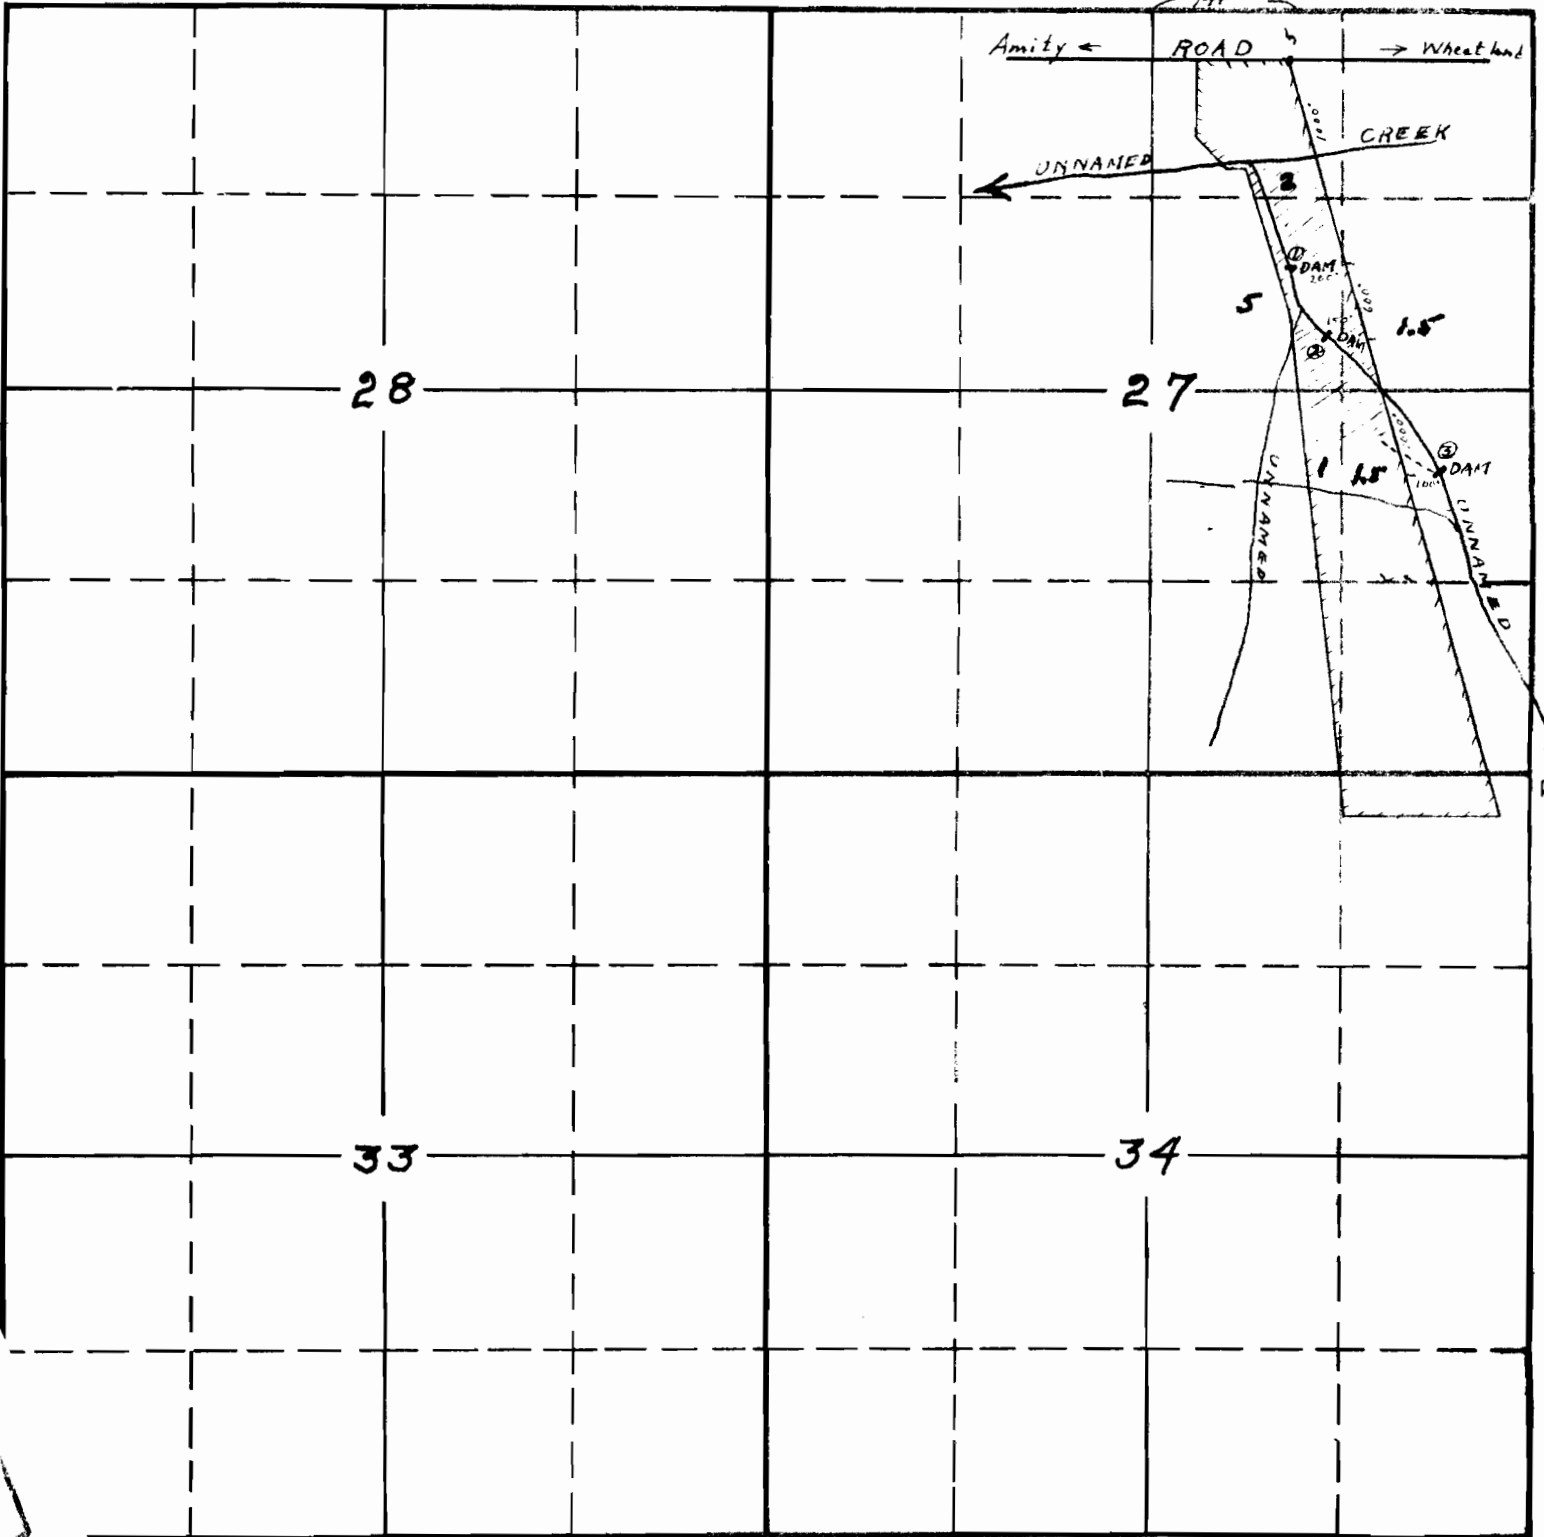

APPLICATION No. 15727
PERMIT No. 11593