


SECTION

TOWNSHIP 4N, RANGE 25E, W. M.

North

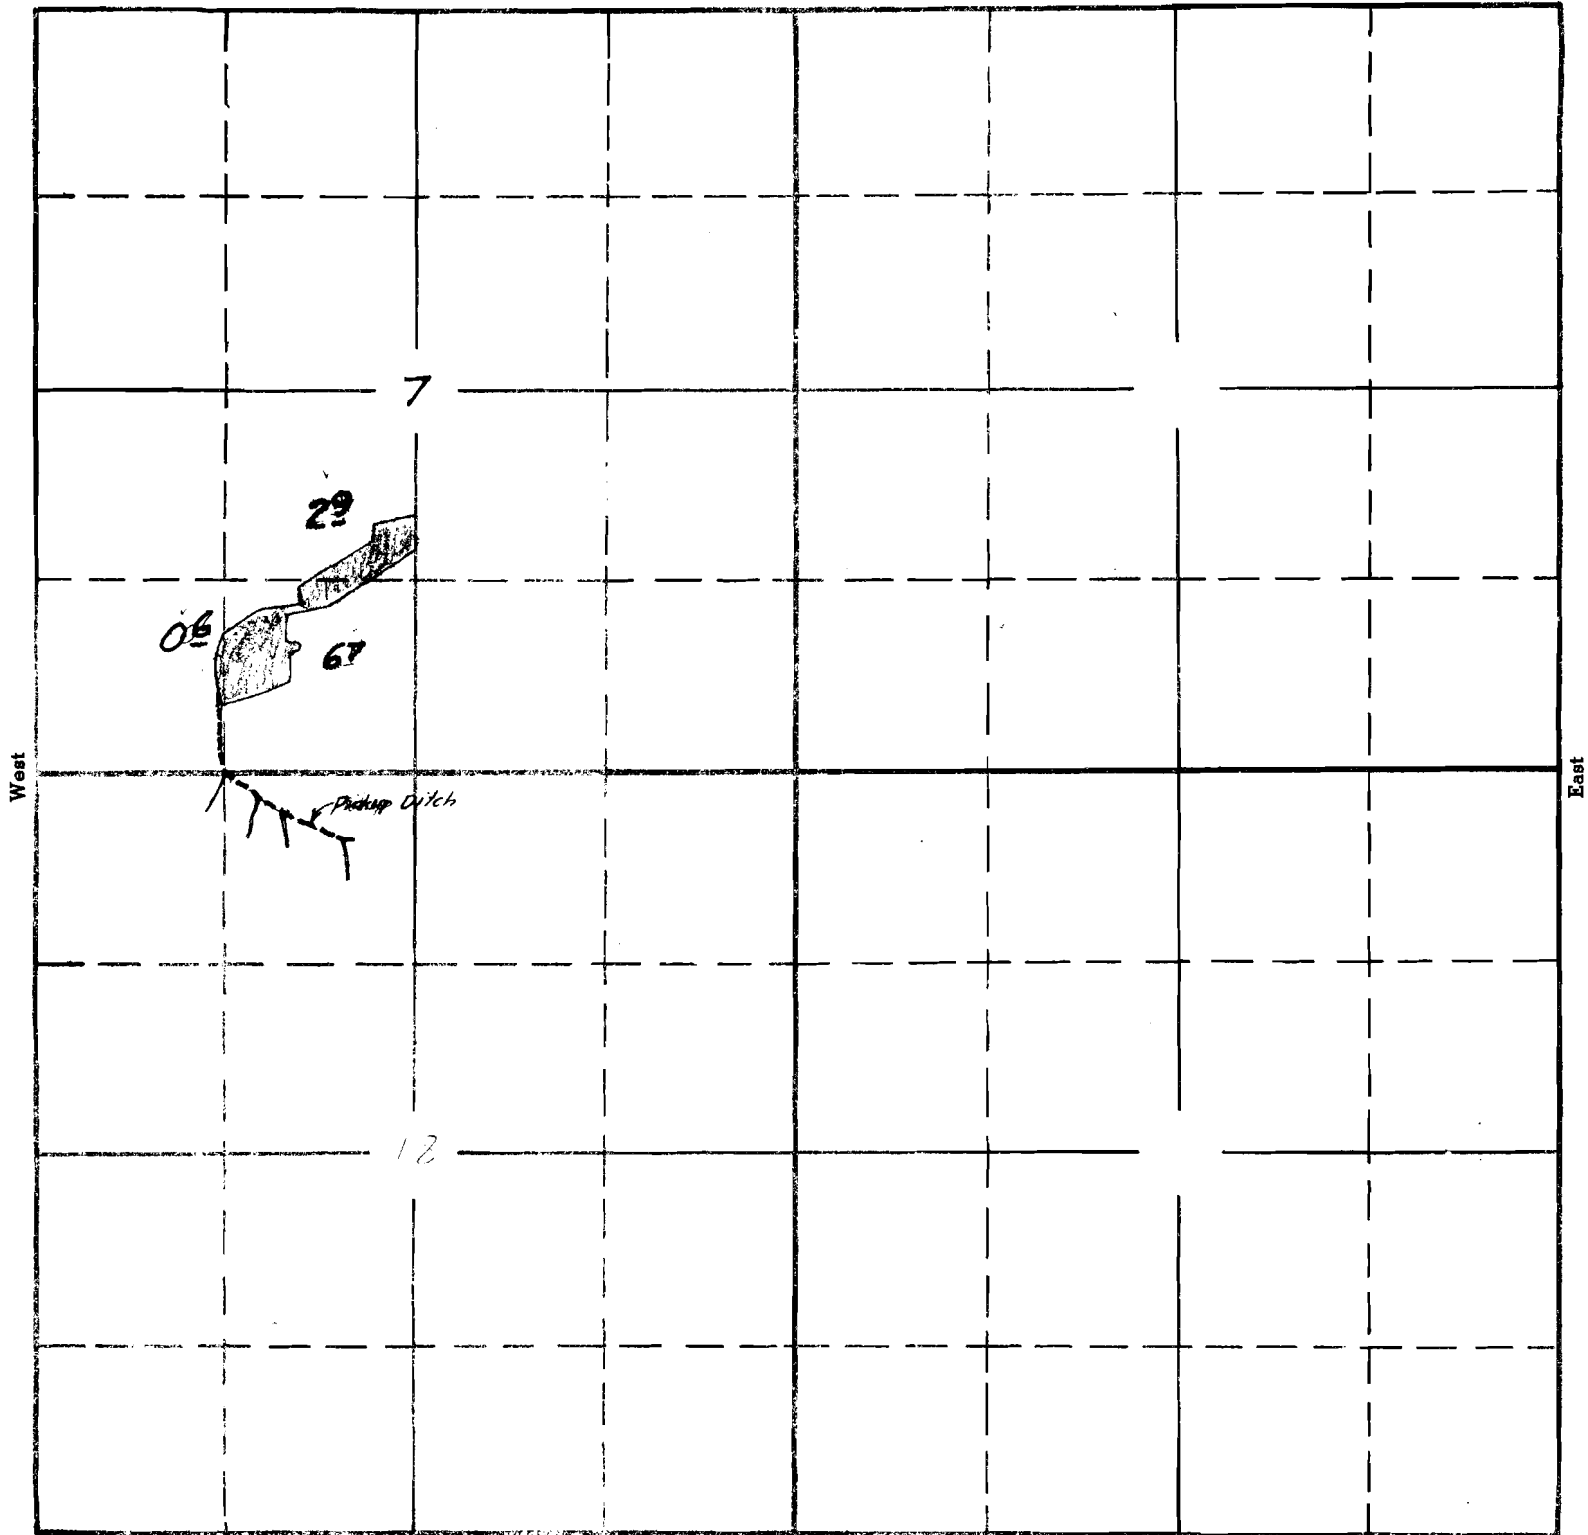

Surveyed Sept 12 1940 *E.A.G.*

South

APPLICATION No. 15741

PERMIT No. 11664