


SECTION

19 & 20

TOWNSHIP 55, RANGE 3W, W. M.

North

West

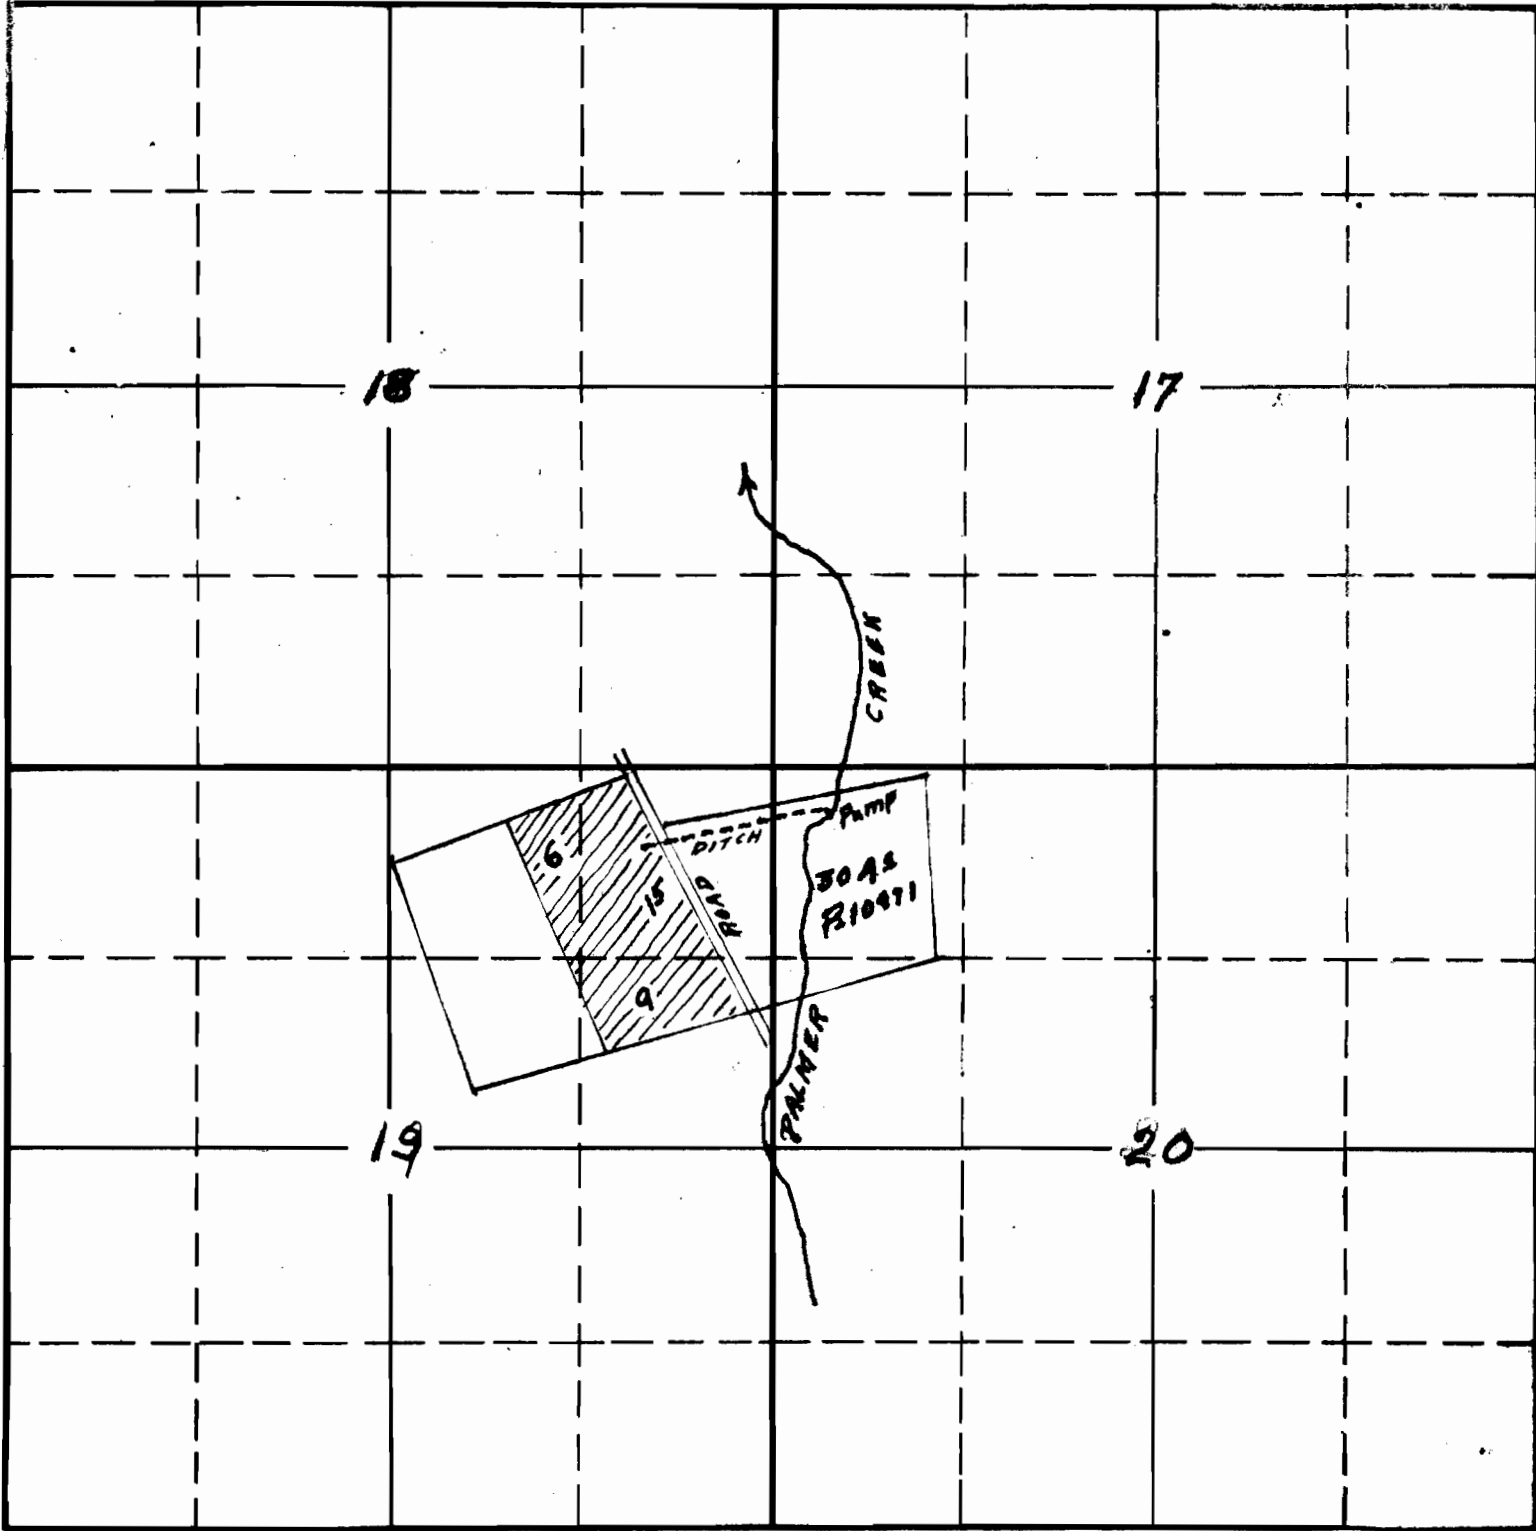

South

2-90A-16132-OK  
 APPLICATION No. 16132  
 PERMIT No. 12002