


SECTION

Per, 12009
13469

TOWNSHIP 105, RANGE 28E, W. M.

North

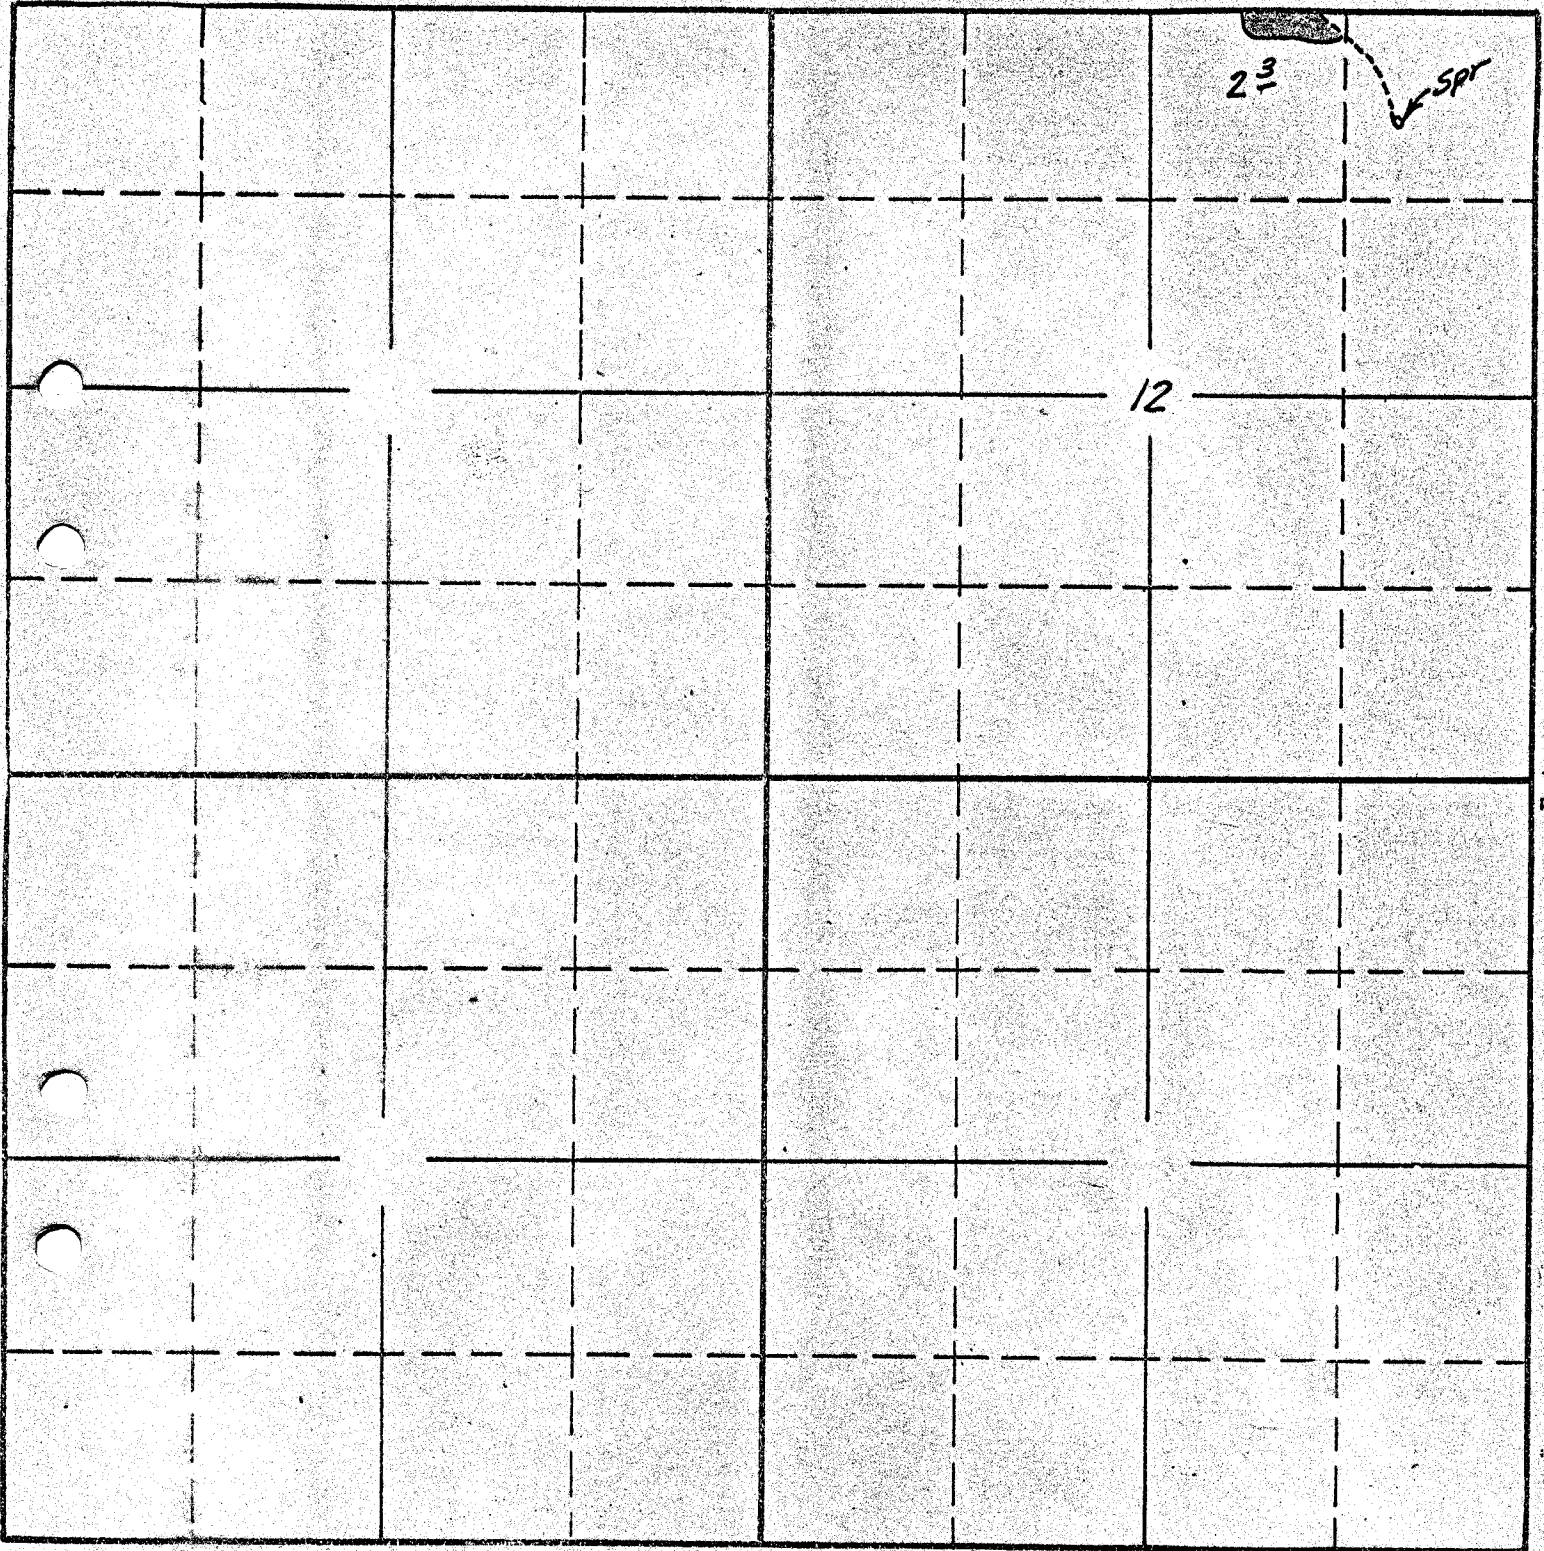

Surveyed Sept 14 1940 G.A.B.

South

*Filed in
Deer Co.*

APPLICATION No. 16190
PERMIT No. 12009