


TOWNSHIP 31, RANGE 11E, W. M.

North

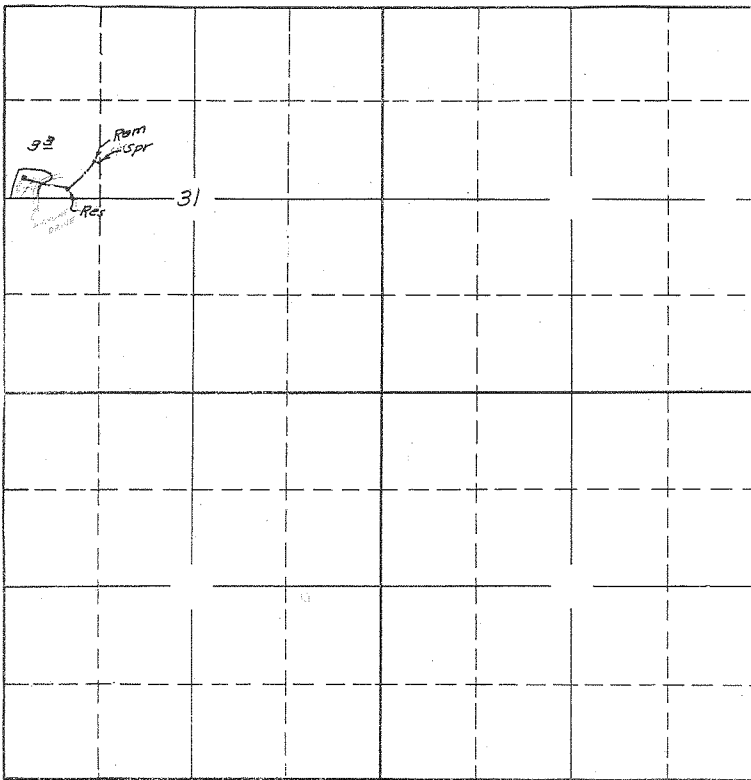

West

South

*Surveyed Sept 10 1940 E.A.L.*

APPLICATION No. 16372

PERMIT No. 12178