


SECTION

12179

13480

TOWNSHIP 36S, RANGE 24E, W. M.

North

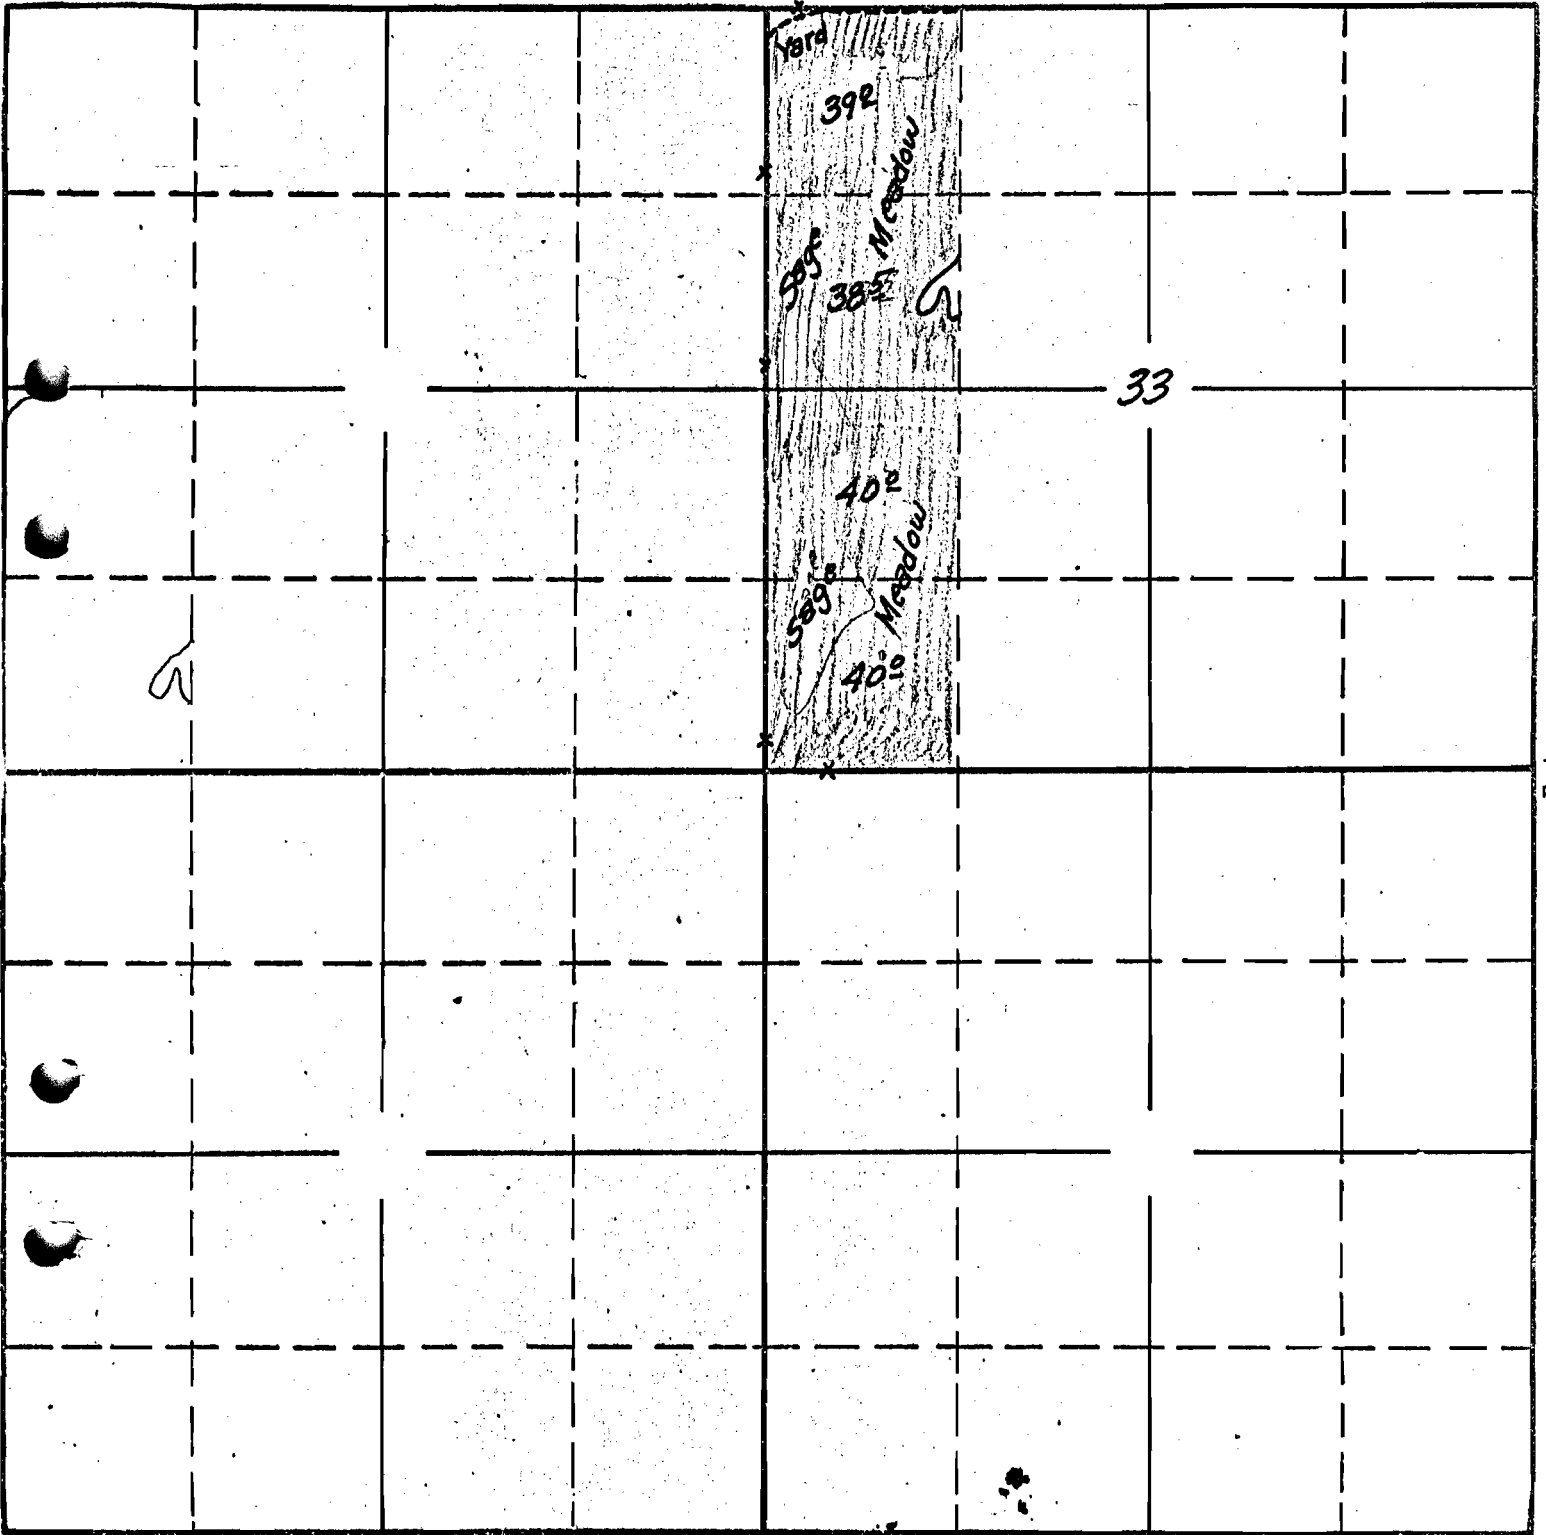

inspected Sept 24 1940

South

APPLICATION No. 16373
PERMIT No. 12179

36-24 ✓